


1 LOCATION OF WATER WELL: Fraction NW 1/4 NE 1/4 SE 1/4 Section Number 29 Township Number T 3 S Range Number R 15 EW
 County: SMITH

Distance and direction from nearest town or city street address of well if located within city?
N of RAILROAD TRACT - W of MAIN

2 WATER WELL OWNER: KENSINGTON CO. OP
 RR#, St. Address, Box # : 228 MAIN KENSINGTON KS Board of Agriculture, Division of Water Resources
 City, State, ZIP Code : Application Number:

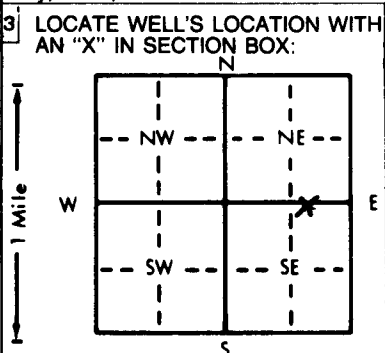

4 DEPTH OF COMPLETED WELL: 50 ft. ELEVATION:
 Depth(s) Groundwater Encountered 36.8 ft. 2. 33.8 ft. 3. - ft.
 WELL'S STATIC WATER LEVEL: 33.8 ft. below land surface measured on mo/day/yr 12-16-92
 Pump test data: Well water was - ft. after - hours pumping - gpm
 Est. Yield 10 gpm: Well water was - ft. after - hours pumping - gpm
 Bore Hole Diameter: 7.25 in. to 50 ft., and - in. to - ft.
 WELL WATER TO BE USED AS:
 1 Domestic 3 Feedlot 6 Oil field water supply 9 Dewatering 12 Other (Specify below)
 2 Irrigation 4 Industrial 7 Lawn and garden only 10 Monitoring well
 Was a chemical/bacteriological sample submitted to Department? Yes - No X; If yes, mo/day/yr sample was sub-
 mitted - Water Well Disinfected? Yes - No X

5 TYPE OF BLANK CASING USED:
 1 Steel 3 RMP (SR) 5 Wrought iron 8 Concrete tile CASING JOINTS: Glued - Clamped -
 2 PVC 4 ABS 6 Asbestos-Cement 9 Other (specify below) Welded -
 7 Fiberglass Threaded X
 Blank casing diameter 2 in. to 25 ft., Dia - in. to - ft., Dia - in. to - ft.
 Casing height above land surface 24 in., weight SCH 40 lbs./ft. Wall thickness or gauge No. -
 TYPE OF SCREEN OR PERFORATION MATERIAL:
 1 Steel 3 Stainless steel 5 Fiberglass 8 RMP (SR) 10 Asbestos-cement
 2 Brass 4 Galvanized steel 6 Concrete tile 9 ABS 11 Other (specify) -
 12 None used (open hole)
 SCREEN OR PERFORATION OPENINGS ARE:
 1 Continuous slot 3 Mill slot 5 Gauzed wrapped 8 Saw cut 11 None (open hole)
 2 Louvered shutter 4 Key punched 6 Wire wrapped 9 Drilled holes
 7 Torch cut 10 Other (specify) -
 SCREEN-PERFORATED INTERVALS: From 25 ft. to 45 ft., From - ft. to - ft.
SAND From - ft. to - ft., From - ft. to - ft.
GRAVEL PACK INTERVALS: From 24 ft. to 50 ft., From - ft. to - ft.
 From - ft. to - ft., From - ft. to - ft.

6 GROUT MATERIAL: 1 Neat cement 2 Cement grout 3 Bentonite 4 Other -
 Grout Intervals: 2 From 0 ft. to 4 ft., 3 From 4 ft. to 24 ft., From - ft. to - ft.
 What is the nearest source of possible contamination:
 1 Septic tank 4 Lateral lines 7 Pit privy 10 Livestock pens 14 Abandoned water well
 2 Sewer lines 5 Cess pool 8 Sewage lagoon 11 Fuel storage 15 Oil well/Gas well
 3 Watertight sewer lines 6 Seepage pit 9 Feedyard 12 Fertilizer storage 16 Other (specify below)
CONTAMINATED AREA
 Direction from well? How many feet?

FROM	TO	LITHOLOGIC LOG	FROM	TO	PLUGGING INTERVALS
0	6.5	FILL			
1.5	14	SILTY CLAY			
14	15.5	SANDY CLAY			
15.5	18.5	SAND			
18.5	20	SANDY CLAY			
20	23	CLAY			
23	26.5	SILT			
26.5	29	SAND			
29	31	SD + GRAVEL			
31	36.8	CLAY			
36.5	50	SAND			

7 CONTRACTOR'S OR LANDOWNER'S CERTIFICATION: This water well was (1) constructed, (2) reconstructed, or (3) plugged under my jurisdiction and was completed on (mo/day/year) 12-15-92 and this record is true to the best of my knowledge and belief. Kansas Water Well Contractor's License No. 479 This Water Well Record was completed on (mo/day/yr) 12-25-92 under the business name of EBBERTS DRILLING by (signature) Morgan Elbert

INSTRUCTIONS: Use typewriter or ball point pen. PLEASE PRESS FIRMLY and PRINT clearly. Please fill in blanks, underline or circle the correct answers. Send top three copies to Kansas Department of Health and Environment, Bureau of Water, Topeka, Kansas 66620-0001. Telephone: 913-296-5545. Send one to WATER WELL OWNER and retain one for your records.