


1 LOCATION OF WATER WELL: County: Smith Fraction: SW 1/4 SE 1/4 NE 1/4 Section Number: 29 Township Number: T 3 S Range Number: R 15 E

Distance and direction from nearest town or city street address of well if located within city?
301 S. Main

2 WATER WELL OWNER: Kensington Co-op
 RR#, St. Address, Box #: Box 128
 City, State, ZIP Code: Kensington, Ks. Board of Agriculture, Division of Water Resources
 OBW-1 Application Number:

3 LOCATE WELL'S LOCATION WITH AN "X" IN SECTION BOX:

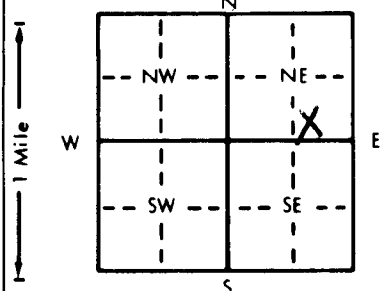

4 DEPTH OF COMPLETED WELL: 50 ft. ELEVATION:
 Depth(s) Groundwater Encountered 1. 37 ft. 2. 50 ft. 3. 50 ft.
 WELL'S STATIC WATER LEVEL: 37 ft. below land surface measured on mo/day/yr
 Pump test data: Well water was _____ ft. after _____ hours pumping _____ gpm
 Est. Yield _____ gpm: Well water was _____ ft. after _____ hours pumping _____ gpm
 Bore Hole Diameter: 6 in. to 50 ft., and _____ in. to _____ ft.
 WELL WATER TO BE USED AS:
 1 Domestic 5 Public water supply 8 Air conditioning 11 Injection well
 2 Irrigation 4 Industrial 7 Lawn and garden only 10 Monitoring well 12 Other (Specify below)
 Was a chemical/bacteriological sample submitted to Department? Yes _____ No X; If yes, mo/day/yr sample was submitted _____
 Water Well Disinfected? Yes _____ No X

5 TYPE OF BLANK CASING USED:
 1 Steel 3 RMP (SR) 5 Wrought iron 8 Concrete tile CASING JOINTS: Glued _____ Clamped _____
 2 PVC 4 ABS 6 Asbestos-Cement 9 Other (specify below) Welded _____
 7 Fiberglass Threaded X
 Blank casing diameter: 2 in. to 30 ft., Dia _____ in. to _____ ft., Dia _____ in. to _____ ft.
 Casing height above land surface: 0 in., weight .716 lbs./ft. Wall thickness or gauge No. 1.54
 TYPE OF SCREEN OR PERFORATION MATERIAL:
 1 Steel 3 Stainless steel 5 Fiberglass 7 PVC 10 Asbestos-cement
 2 Brass 4 Galvanized steel 6 Concrete tile 8 RMP (SR) 11 Other (specify) _____
 9 ABS 12 None used (open hole)
 SCREEN OR PERFORATION OPENINGS ARE:
 1 Continuous slot 3 Mill slot 5 Gauzed wrapped 8 Saw cut 11 None (open hole)
 2 Louvered shutter 4 Key punched 6 Wire wrapped 9 Drilled holes
 7 Torch cut 10 Other (specify) _____
 SCREEN-PERFORATED INTERVALS: From 30 ft. to 50 ft. From _____ ft. to _____ ft.
 GRAVEL PACK INTERVALS: From 28 ft. to 50 ft. From _____ ft. to _____ ft.

6 GROUT MATERIAL: 1 Neat cement 2 Cement grout 3 Bentonite 4 Other _____
 Grout Intervals: From 0 ft. to 25 ft. From 25 ft. to 28 ft. From _____ ft. to _____ ft.
 What is the nearest source of possible contamination:
 1 Septic tank 4 Lateral lines 7 Pit privy 10 Livestock pens 14 Abandoned water well
 2 Sewer lines 5 Cess pool 8 Sewage lagoon 11 Fuel storage 15 Oil well/Gas well
 3 Watertight sewer lines 6 Seepage pit 9 Feedyard 12 Fertilizer storage 16 Other (specify below)
Removed Fuel Storage
 Direction from well? _____ How many feet? _____

FROM	TO	LITHOLOGIC LOG	FROM	TO	PLUGGING INTERVALS
0	5	Med. to Drk. Bwn. Silt&Sand			
5	10	Drk. Brwn Sandy Clay to Slightly Silty Sand			
10	15	Med. Brwn Silty Sand to Fine Sand			
15	20	Lite to Dark Tan Silty Sand			
20	25	Drk. Brwn Sandy Silt to Very Fine Sand			
25	50	Tan to Lite Brwn Sand			

7 CONTRACTOR'S OR LANDOWNER'S CERTIFICATION: This water well was (1) constructed, (2) reconstructed, or (3) plugged under my jurisdiction and was completed on (mo/day/year) 8-15-94 and this record is true to the best of my knowledge and belief. Kansas Water Well Contractor's License No. 554. This Water Well Record was completed on (mo/day/yr) 8-16-94 under the business name of Woofter Pump & Well, Inc. by (signature) Kay C. Woofter

INSTRUCTIONS: Use typewriter or ball point pen. PLEASE PRESS FIRMLY and PRINT clearly. Please fill in blanks, underline or circle the correct answers. Send top three copies to Kansas Department of Health and Environment, Bureau of Water, Topeka, Kansas 66620-0001. Telephone: 913-296-5545. Send one to WATER WELL OWNER and retain one for your records.

OFFICE USE ONLY

T

R

EW

SEC.

1/4

1/4

1/4