


1 LOCATION OF WATER WELL: Fraction SW 1/4 SE 1/4 NE 1/4 Section Number 29 Township Number T 3 S Range Number R 15 EW

Distance and direction from nearest town or city street address of well if located within city?

2 WATER WELL OWNER: Kensington Co-op Board of Agriculture, Division of Water Resources RR#, St. Address, Box #: Kensington, Ks. 66951 MW #21 Application Number: City, State, ZIP Code:

3 LOCATE WELL'S LOCATION WITH AN "X" IN SECTION BOX:

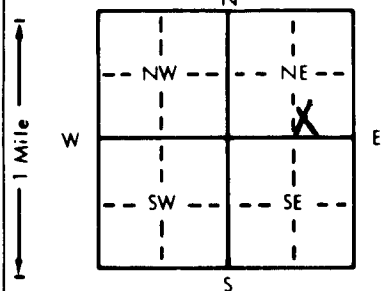

4 DEPTH OF COMPLETED WELL: 50 ft. ELEVATION:

Depth(s) Groundwater Encountered 1. .ft. 2. .ft. 3. .ft. WELL'S STATIC WATER LEVEL .35 .ft. below land surface measured on mo/day/yr Pump test data: Well water was .ft. after . hours pumping . gpm Est. Yield . gpm: Well water was .ft. after . hours pumping . gpm Bore Hole Diameter .8 .in. to .50 .ft., and .in. to .ft. WELL WATER TO BE USED AS: 5 Public water supply 8 Air conditioning 11 Injection well 1 Domestic 3 Feedlot 6 Oil field water supply 9 Dewatering 12 Other (Specify below) 2 Irrigation 4 Industrial 7 Lawn and garden only 10 Monitoring well Was a chemical/bacteriological sample submitted to Department? Yes. . No X. ; If yes, mo/day/yr sample was submitted Water Well Disinfected? Yes No X

5 TYPE OF BLANK CASING USED: 1 Steel 3 RMP (SR) 5 Wrought iron 8 Concrete tile CASING JOINTS: Glued . Clamped . 2 PVC 4 ABS 6 Asbestos-Cement 9 Other (specify below) Welded . 7 Fiberglass Threaded . Blanking diameter .2 .in. to .29 .ft., Dia .in. to .ft., Dia .in. to .ft. Casing height above land surface .0 .in., weight .716 .lbs./ft. Wall thickness or gauge No. 154

TYPE OF SCREEN OR PERFORATION MATERIAL: 1 Steel 3 Stainless steel 5 Fiberglass 8 RMP (SR) 11 Other (specify) 2 Brass 4 Galvanized steel 6 Concrete tile 9 ABS 12 None used (open hole)

SCREEN OR PERFORATION OPENINGS ARE: 1 Continuous slot 3 Mill slot 5 Gauzed wrapped 8 Saw cut 11 None (open hole) 2 Louvered shutter 4 Key punched 6 Wire wrapped 9 Drilled holes 7 Torch cut 10 Other (specify)

SCREEN-PERFORATED INTERVALS: From .29 .ft. to .49 .ft., From .ft. to .ft. GRAVEL PACK INTERVALS: From .25 .ft. to .49 .ft., From .ft. to .ft.

6 GROUT MATERIAL: 1 Neat cement 2 Cement grout 3 Bentonite 4 Other Grout intervals: From .0 .ft. to .18 .ft., From .18 .ft. to .25 .ft., From .ft. to .ft.

What is the nearest source of possible contamination: 1 Septic tank 4 Lateral lines 7 Pit privy 11 Fuel storage 14 Abandoned water well 2 Sewer lines 5 Cess pool 8 Sewage lagoon 12 Fertilizer storage 15 Oil well/Gas well 3 Watertight sewer lines 6 Seepage pit 9 Feedyard 13 Insecticide storage 16 Other (specify below) Removed Fuel Stor.

Direction from well? How many feet?

Table with columns: FROM, TO, LITHOLOGIC LOG, FROM, TO, PLUGGING INTERVALS. Rows: 0-10 Sandy Silt, 10-15 Clayey Silt, 15-30 Sandy Silt, 30-50 Sand.

7 CONTRACTOR'S OR LANDOWNER'S CERTIFICATION: This water well was (1) constructed, (2) reconstructed, or (3) plugged under my jurisdiction and was completed on (mo/day/year) 10-13-94 and this record is true to the best of my knowledge and belief. Kansas Water Well Contractor's License No. 554 This Water Well Record was completed on (mo/day/yr) 10-17-94 under the business name of Woofter Pump & Well, Inc. by (signature) Jay C. Woofter

INSTRUCTIONS: Use typewriter or ball point pen. PLEASE PRESS FIRMLY and PRINT clearly. Please fill in blanks, underline or circle the correct answers. Send top three copies to Kansas Department of Health and Environment, Bureau of Water, Topeka, Kansas 66620-0001. Telephone: 913-296-5545. Send one to WATER WELL OWNER and retain one for your records.