


1 LOCATION OF WATER WELL: County: PHILLIPS Fraction: SE 1/4 SE 1/4 NE 1/4 Section Number: 13 Township Number: T 3 S Range Number: R 16 EW

Distance and direction from nearest town or city street address of well if located within city? 2 1/2 miles East and 1 mile North of Agra KS

2 WATER WELL OWNER: DONALD GRAUERHOLZ RR#, St. Address, Box #: RR1 BOX 116 City, State, ZIP Code: KENSINGTON KS 6766951 Board of Agriculture, Division of Water Resources Application Number:

3 LOCATE WELL'S LOCATION WITH AN "X" IN SECTION BOX:

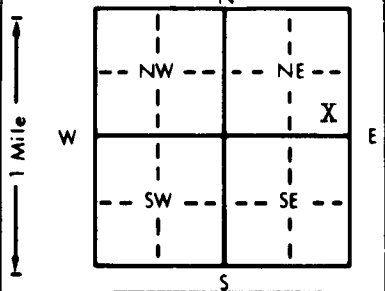

4 DEPTH OF COMPLETED WELL: 56 ft. ELEVATION: 30 ft. WELL'S STATIC WATER LEVEL: 30 ft. below land surface measured on mo/day/yr 3-12-96

Pump test data: Well water was 60 gpm after 3 hours pumping. Bore Hole Diameter: 5 in. to 56 in. WELL WATER TO BE USED AS: 5 Public water supply, 8 Air conditioning, 11 Injection well, XX Domestic, 3 Feedlot, 6 Oil field water supply, 9 Dewatering, 12 Other (Specify below), 2 Irrigation, 4 Industrial, 7 Lawn and garden only, 10 Monitoring well. Was a chemical/bacteriological sample submitted to Department? Yes No XX; If yes, mo/day/yr sample was submitted Water Well Disinfected? Yes No XX

5 TYPE OF BLANK CASING USED: 1 Steel, 3 RMP (SR), XX PVC, 4 ABS. 5 Wrought iron, 6 Asbestos-Cement, 7 Fiberglass. 8 Concrete tile, 9 Other (specify below). CASING JOINTS: Glued XX, Clamped, Welded, Threaded.

Blank casing diameter: 5 in. to 40 in., Dia. 30 in., weight 160 lbs./ft. Wall thickness or gauge No.

TYPE OF SCREEN OR PERFORATION MATERIAL: XX PVC, 10 Asbestos-cement, 1 Steel, 3 Stainless steel, 5 Fiberglass, 8 RMP (SR), 11 Other (specify), 2 Brass, 4 Galvanized steel, 6 Concrete tile, 9 ABS, 12 None used (open hole)

SCREEN OR PERFORATION OPENINGS ARE: 1 Continuous slot, XX Mill slot, 2 Louvered shutter, 4 Key punched, 5 Gauzed wrapped, 6 Wire wrapped, 7 Torch cut, 8 Saw cut, 9 Drilled holes, 11 None (open hole)

SCREEN-PERFORATED INTERVALS: From 40 ft. to 56 ft. GRAVEL PACK INTERVALS: From 30 ft. to 56 ft.

6 GROUT MATERIAL: 1 Neat cement, 2 Cement grout, XX Bentonite, 4 Other. Grout Intervals: From 0 ft. to 30 ft.

What is the nearest source of possible contamination: 1 Septic tank, 2 Sewer lines, 3 Watertight sewer lines, 4 Lateral lines, 5 Cess pool, 6 Seepage pit, 7 Pit privy, 8 Sewage lagoon, 9 Feedyard, 10 Livestock pens, 11 Fuel storage, 12 Fertilizer storage, 13 Insecticide storage, 14 Abandoned water well, 15 Oil well/Gas well, 16 Other (specify below)

Direction from well? How many feet?

Table with columns: FROM, TO, LITHOLOGIC LOG, FROM, TO, PLUGGING INTERVALS. Rows: 0-8 Surface Clays, 8-25 Very Hard Clays, 25-30 Brown silt clay soft, 30-40 Med. Sand, 40-50 Med to large Sand, 50-55 Large Sand, 55-56 Flint rock.

7 CONTRACTOR'S OR LANDOWNER'S CERTIFICATION: This water well was (1) constructed, (2) reconstructed, or (3) plugged under my jurisdiction and was completed on (mo/day/year) 3-12-96 and this record is true to the best of my knowledge and belief. Kansas Water Well Contractor's License No. 444 This Water Well Record was completed on (mo/day/yr) 3-12-96 under the business name of ANDERSON DRILLING by (signature) Andy Anderson

INSTRUCTIONS: Use typewriter or ball point pen. PLEASE PRESS FIRMLY and PRINT clearly. Please fill in blanks, underline or circle the correct answers. Send top three copies to Kansas Department of Health and Environment, Bureau of Water, Topeka, Kansas 66620-0001. Telephone: 913-296-5545. Send one to WATER WELL OWNER and retain one for your records.