


1 LOCATION OF WATER WELL: Fraction Section Number Township Number Range Number
County: Phillips SE ¼ SW ¼ NE ¼ 35 T 3 S R 16 EW

Distance and direction from nearest town or city street address of well if located within city?
1 Mile East, 1/2 mile South of Agra Kansas

2 WATER WELL OWNER: Dennis Miller
RR#, St Address, Box # : 625 Jansonius, P.O. Box 266 Board of Agriculture, Division of Water Resources
City, State, ZIP Code : Phillipsburg, Kansas 67661 Application Number:

3 LOCATE WELL'S LOCATION WITH AN "X" IN SECTION BOX: 4 DEPTH OF COMPLETED WELL 80 ft ELEVATION: 0
Depth(s) Groundwater Encountered 1. 999 ft 2. ft 3. ft
WELL'S STATIC WATER LEVEL . . . 40.8 . . . ft below land surface measured on mo/day/yr 4/23/97
Pump test data: Well water was . . . NA . . . ft after hours pumping gpm
Est. Yield . . NA . . . gpm: Well water was . . . ft after hours pumping gpm
Bore Hole Diameter . . . 8 . . . in. to . . . 85 . . . ft. and in. to ft
WELL WATER TO BE USED AS: 5 Public water supply 8 Air conditioning 11 Injection well
1 Domestic 3 Feedlot 6 Oil field water supply 9 Dewatering 12 Other (Specify below)
2 Irrigation 4 Industrial 7 Lawn and garden only 10 Monitoring well
Was a chemical/bacteriological sample submitted to Department: Yes.....No✓.....; If yes, mo/day/yr sample was submitted
Water Well Disinfected? Yes No ✓

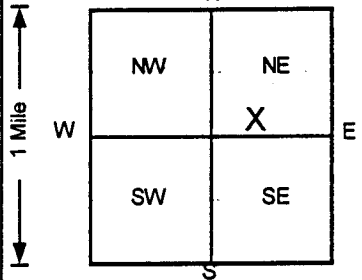

OFFICE USE ONLY

5 TYPE OF BLANK CASING USED: 5 Wrought iron 8 Concrete tile CASING JOINTS: Glued Clamped
1 Steel 3 RMP (SR) 6 Asbestos-Cement 9 Other (specify below) Welded
2 PVC 4 ABS 7 Fiberglass Threaded. ✓
Blank casing diameter 5 in. to 55 ft. Dia in. to ft. Dia in. to ft
Casing height above land surface 24 in., weight Sch 40 lbs./ft. Wall thickness or gauge No.
TYPE OF SCREEN OR PERFORATION MATERIAL (7) PVC 10 Asbestos-cement
1 Steel 3 Stainless steel 5 Fiberglass 8 RMP (SR) 11 Other (specify)
2 Brass 4 Galvanized steel 6 Concrete tile 9 ABS 12 None used (open hole)
SCREEN OR PERFORATION OPENINGS ARE: 5 Gauzed wrapped 8 Saw cut 11 None (open hole)
1 Continuous slot (3) Mill slot 6 Wire wrapped 9 Drilled holes
2 Louvered shutter 4 Key punched 7 Torch cut 10 Other (specify)
SCREEN-PERFORATED INTERVALS: From 55 ft to 80 ft, From ft to ft
From ft to ft, From ft to ft
GRAVEL PACK INTERVALS: From 50.5 ft to 85 ft, From ft to ft
From ft to ft, From ft to ft

T

R

6 GROUT MATERIAL: 1 Neat cement (2) Cement grout (3) Bentonite 4 Other
Grout Intervals: From 0 ft to . . 25.5 CEM . . ft, From . . 25 . . ft to . . 39 BEN . . ft, From . . 39 . . ft to . . 50.5 BEN . ft
What is the nearest source of possible contamination: 10 Livestock pens 14 Abandoned water well
1 Septic tank 4 Lateral lines 7 Pit privy 11 Fuel storage 15 Oil well/Gas well
2 Sewer lines 5 Cess pool 8 Sewage lagoon 12 Fertilizer storage (16) Other (specify below)
3 Watertight sewer lines 6 Seepage pit 9 Feedyard 13 Insecticide storage . . . Unknown
Direction from well? How many feet? 0

EW

Table with columns FROM, TO, LITHOLOGIC LOG, FROM, TO, PLUGGING INTERVALS. Rows include: 0-3 Top Soil, Dark Yellowish Brown; 3-15 Clayey Silt, Olive Gray to Dark Yellow Brown; 15-54 Clayey Silt/Silty Clay, Dark Yellow Orange to; 54-77.5 Sand, Dark Yellowish Orange; 77.5-84.5 Clayey Silt, Dark Yellow/Green; 84.5-85 Shale, Olive Gray.

SEC.

1/4

1/4

1/4

7 CONTRACTOR'S OR LANDOWNER'S CERTIFICATION: This water well was (1) constructed, (2) reconstructed, or (3) plugged under my jurisdiction and was completed on (mo/day/year) 4/23/97 and this record is true to the best of my knowledge and belief.
Kansas Water Well Contractor's License No. 527 This Water Well Record was completed on (mo/day/yr) 6/20/97
under the business name of GeoCore Services, Inc. by (signature) Dale A. Roll

INSTRUCTIONS: Use typewriter or ball point pen. PLEASE PRESS FIRMLY and PRINT clearly. Please fill in blanks, underline or circle the correct answers. Send top three copies to Kansas Department of Health and Environment, Bureau of Water, Topeka, Kansas 68820-0001. Telephone: 913-298-5545. Send one to WATER WELL OWNER and retain one for your records.