


1 LOCATION OF WATER WELL: County: Phillips Fraction: SW 1/4 SE 1/4 NW 1/4 Section Number: 27 Township Number: T 3 S Range Number: R 16 EW

Distance and direction from nearest town or city street address of well if located within city?

City of Agra

2 WATER WELL OWNER: KDHE Forbes Field Bldg 740 Topeka, KS 66620 Board of Agriculture, Division of Water Resources  
 RR#, St. Address, Box #: Topoka, KS 66620 MW#P          Application Number:         

3 LOCATE WELL'S LOCATION WITH AN "X" IN SECTION BOX:

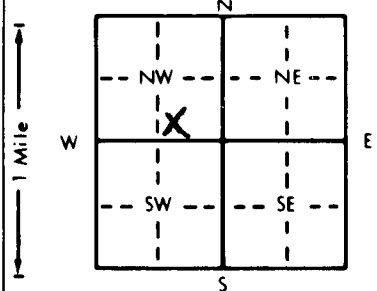

4 DEPTH OF COMPLETED WELL: 59' ft. ELEVATION:          ft.  
 Depth(s) Groundwater Encountered: 1 ft. 2.          ft. 3.          ft.  
 WELL'S STATIC WATER LEVEL: 42.9 ft. below land surface measured on mo/day/yr  
 Pump test data: Well water was          ft. after          hours pumping          gpm  
 Est. Yield          gpm: Well water was          ft. after          hours pumping          gpm  
 Bore Hole Diameter: 8.75 in. to 59 ft., and          in. to          ft.  
 WELL WATER TO BE USED AS:  
 1 Domestic          3 Feedlot          6 Oil field water supply          9 Dewatering          12 Other (Specify below)  
 2 Irrigation          4 Industrial          7 Lawn and garden only          10 Monitoring well  
 Was a chemical/bacteriological sample submitted to Department? Yes          No X; If yes, mo/day/yr sample was submitted           
 Water Well Disinfected? Yes          No X

5 TYPE OF BLANK CASING USED:  
 1 Steel          3 RMP (SR)          6 Asbestos-Cement          9 Other (specify below)           
 2 PVC          4 ABS          7 Fiberglass          10 Asbestos-cement           
 Blank casing diameter: 2 in. to 39.5 ft., Dia.          in. to          ft., Dia.          in. to          ft.  
 Casing height above land surface: 36 in., weight          lbs./ft. Wall thickness or gauge No.           
 TYPE OF SCREEN OR PERFORATION MATERIAL:  
 1 Steel          3 Stainless steel          5 Fiberglass          8 RMP (SR)          11 Other (specify)           
 2 Brass          4 Galvanized steel          6 Concrete tile          9 ABS          12 None used (open hole)         

SCREEN OR PERFORATION OPENINGS ARE:  
 1 Continuous slot          3 Mill slot          6 Wire wrapped          9 Drilled holes           
 2 Louvered shutter          4 Key punched          7 Torch cut          10 Other (specify)           
 SCREEN-PERFORATED INTERVALS: From 39.5 ft. to 59 ft., From          ft. to          ft.  
 From          ft. to          ft., From          ft. to          ft.  
 GRAVEL PACK INTERVALS: From 34 ft. to 59 ft., From          ft. to          ft.  
 From          ft. to          ft., From          ft. to          ft.

6 GROUT MATERIAL: 1 Neat cement          2 Cement grout 3 Bentonite 4 Other           
 Grout intervals: From 0 ft. to 2 ft., From 20 ft. to 34 ft., From          ft. to          ft.  
 What is the nearest source of possible contamination:  
 1 Septic tank          4 Lateral lines          7 Pit privy          10 Livestock pens          14 Abandoned water well           
 2 Sewer lines          5 Cess pool          8 Sewage lagoon          11 Fuel storage          15 Oil well/Gas well           
 3 Watertight sewer lines          6 Seepage pit          9 Feedyard          12 Fertilizer storage          16 Other (specify below): Contaminated site  
 13 Insecticide storage         

Direction from well?          How many feet?         

FROM	TO	LITHOLOGIC LOG	FROM	TO	PLUGGING INTERVALS
0	4	clay, grass roots			
4	6	clay w/ top soil			
6	7	clay black, stiff			
7	10	clay, lt brown			
10	20	silt and clay			
20	24	silt w/ trace of clay			
24	28	silt & clay			
28	29	fine sand			
29	31	silt & clay			
31	32	clay			
32	34	silt & clay			
34	50	silt w/ trace of clay			
50	58	clay & silt			
58	59	coat se gravel			

7 CONTRACTOR'S OR LANDOWNER'S CERTIFICATION: This water well was (1) constructed, (2) reconstructed, or (3) plugged under my jurisdiction and was completed on (mo/day/year) 2-25-98 and this record is true to the best of my knowledge and belief. Kansas Water Well Contractor's License No. 554 This Water Well Record was completed on (mo/day/yr) 4-30-98 under the business name of Woofter Pump & Well, Inc by (signature)