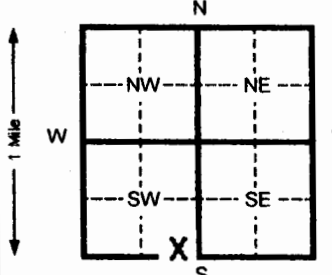


1 LOCATION OF WATER WELL: County: <b>Phillips</b>	Fraction <b>SE 1/4 SE 1/4 SW 1/4</b>	Section Number <b>27</b>	Township Number T <b>3</b> S	Range Number R <b>16</b> E/W
Distance and direction from nearest town or city street address of well if located within city? <b>Aquaterra Environmental Solutions, Inc. 819 E. Frontage Rd. Opeka, KS</b>				
2 WATER WELL OWNER: RR#, St. Address, Box # City, State, ZIP Code		Board of Agriculture, Division of Water Resources Application Number:		
3 LOCATE WELL'S LOCATION WITH AN "X" IN SECTION BOX: 		4 DEPTH OF COMPLETED WELL <b>55</b> ft. ELEVATION: Depth(s) Groundwater Encountered 1 _____ ft. 2 _____ ft. 3 _____ ft. WELL'S STATIC WATER LEVEL _____ ft. below land surface measured on mo/day/yr Pump test data: Well water was _____ ft. after _____ hours pumping _____ gpm Est. Yield _____ gpm: Well water was _____ ft. after _____ hours pumping _____ gpm Bore Hole Diameter <b>8</b> in. to <b>56</b> ft. and _____ in. to _____ ft. WELL WATER TO BE USED AS: 5 Public water supply 8 Air conditioning 11 Injection well 1 Domestic 3 Feed lot 6 Oil field water supply 9 Dewatering 12 Other (Specify below) 2 Irrigation 4 Industrial 7 Lawn and garden (domestic) <b>10</b> Monitoring well Was a chemical/bacteriological sample submitted to Department? Yes _____ No <b>X</b> If yes, mo/day/yr sample was submitted Water Well Disinfected? Yes _____ No <b>X</b>		
5 TYPE OF BLANK CASING USED: 1 Steel 3 RMP (SR) 5 Wrought Iron 8 Concrete tile CASING JOINTS: Glued _____ Clamped _____ <b>2</b> PVC 4 ABS 6 Asbestos-Cement 9 Other (specify below) Welded _____ 7 Fiberglass _____ Threaded _____ Blank casing diameter <b>2</b> in. to <b>35</b> ft., Dia _____ in. to _____ ft., Dia _____ in. to _____ ft. Casing height above land surface <b>0</b> in., weight <b>.716</b> lbs./ft. Wall thickness or gauge No. <b>.154</b> TYPE OF SCREEN OR PERFORATION MATERIAL: <b>7</b> PVC 10 Asbestos-cement 1 Steel 3 Stainless steel 5 Fiberglass 8 RMP (SR) 11 Other (specify) _____ 2 Brass 4 Galvanized steel 6 Concrete tile 9 ABS 12 None used (open hole) _____ SCREEN OR PERFORATION OPENINGS ARE: 5 Gauzed wrapped <b>8</b> Saw cut 11 None (open hole) 1 Continuous slot 3 Mill slot 6 Wire wrapped 9 Drilled holes 2 Louvered shutter 4 Key punched 7 Torch cut 10 Other (specify) _____ SCREEN-PERFORATED INTERVALS: From <b>35</b> ft. to <b>55</b> ft. From _____ ft. to _____ ft. GRAVEL PACK INTERVALS: From <b>33</b> ft. to <b>55</b> ft. From _____ ft. to _____ ft.				
6 GROUT MATERIAL: <b>1</b> Neat cement 2 Cement grout <b>3</b> Bentonite 4 Other Grout Intervals From <b>0</b> ft. to <b>31</b> ft. From <b>31</b> ft. to <b>33</b> ft. From _____ ft. to _____ ft. What is the nearest source of possible contamination: 1 Septic tank 4 Lateral lines 7 Pit privy 10 Livestock pens 14 Abandoned water well 2 Sewer lines 5 Cess pool 8 Sewage lagoon 11 Fuel storage 15 Oil well/ Gas well 3 Watertight sewer lines 6 Seepage pit 9 Feedyard 12 Fertilizer storage 16 Other (specify below) <b>Contaminated site</b> Direction from well? How many feet? FROM TO CODE LITHOLOGIC LOG FROM TO PLUGGING INTERVALS <b>0 2 Asphalt</b> <b>2 20 clay w/sand lenses</b> <b>20 51 Clay w/caliche strks</b> <b>51 56 Clay &amp; caliche w/sand lenses</b>				
7 CONTRACTOR'S OR LANDOWNER'S CERTIFICATION: This water well was (1) <u>constructed</u> , (2) reconstructed, or (3) plugged under my jurisdiction and was completed on (mo/day/yr) <b>6-25-08</b> and this record is true to the best of my knowledge and belief. Kansas Water Well Contractor's License No. <b>783</b> This Water Well Record was completed on (mo/day/yr) <b>7-18-08</b> under the business name of <b>Woofter Pump &amp; Well Inc.</b> by (signature) <i>[Signature]</i> INSTRUCTIONS: Please fill in blanks and circle the correct answers. Send three copies to Kansas Department of Health and Environment, Bureau of Water, 1000 S W Jackson St., Ste. 420, Topeka, Kansas 66612-1367. Telephone: 913-296-5545. Send one to WATER WELL OWNER and retain one for your records.				

OFFICE USE ONLY

T

R

SEC