


1 LOCATION OF WATER WELL: County: Phillips	Fraction NE ¼ NW ¼ SW ¼	Section Number 27	Township Number 3S	Range Number 16W
---	-----------------------------------	-----------------------------	------------------------------	----------------------------

Distance and direction from nearest town or city street address of well if located within city?
Southeast corner of Railroad and Main St

2 WATER WELL OWNER: Ks Dept of Health & Environ. RR#, St. Address, Box #: City, State, ZIP Code: Topeka, Ks	Global Positioning System (decimal degrees, min. of 4 digits) Latitude: <u>39.76278</u> Longitude: <u>99.11906</u> Elevation: _____ Datum: _____ Data Collection Method: _____
--	--

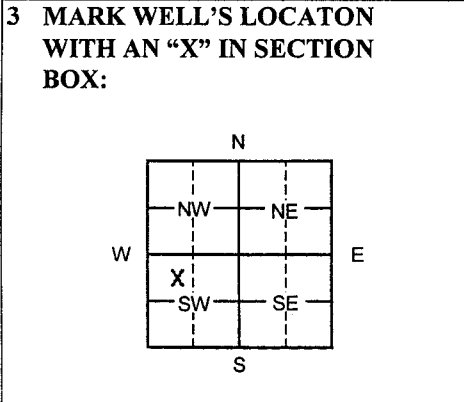

4 DEPTH OF WELL 63 ft. (MW1 – well installed in 1987)

WELL'S STATIC WATER LEVEL Not measured ft.

WELL WAS USED AS:

1 Domestic	5 Public Water Supply	9 Dewatering
2 Irrigation	6 Oil Field Water Supply	10 Monitoring
3 Feedlot	7 Domestic (Lawn & Garden)	11 Injection Well
4 Industrial	8 Air Conditioning	12 Other _____

Was a chemical/bacteriological sample submitted to Department? Yes ___ No X

5 TYPE OF BLANK CASING USED:

1 Steel	3 RMP (SR)	5 Wrought	7 Fiberglass	9 Other (specify below)
2 PVC	4 ABS	6 Asbestos-Cement	8 Concrete Tile	

Blank casing diameter 2 in. Was casing pulled? Yes X No ___ If yes, how much 6 ft (to 3 ft below ground surface)
Casing height above or below land surface ~3 ft above in.

6 GROUT PLUG MATERIAL: 1 Neat cement 2 Cement grout 3 Bentonite 4 Other Soil: 0-3 ft

Grout Plug Intervals: From 3 ft. to 63 ft., From _____ ft. to _____ ft., From _____ ft. to _____ ft.

What is the nearest source of possible contamination:

1 Septic tank	6 Seepage pit	11 Fuel storage	<u>6 Other (specify below)</u>
2 Sewer lines	7 Pit privy	12 Fertilizer storage	<u>Grain Bins in vicinity</u>
3 Watertight sewer lines	8 Sewage lagoon	13 Insecticide storage	
4 Lateral lines	9 Feedyard	14 Abandoned water well	Direction from well?
5 Cess pool	10 Livestock pens	15 Oil well/Gas well	How many feet?

FROM	TO	PLUGGING MATERIALS	FROM	TO	PLUGGING MATERIALS
0	3	Topsoil			
3	63	Bentonite – med chip			

7 CONTRACTOR'S OR LANDOWNER'S CERTIFICATION: This water well was plugged under my jurisdiction and was completed on (mo/day/year) 10/29/08 and this record is true to the best of my knowledge and belief. Kansas Water Well Contractor's License No. 757. This Water Well Record was completed on (mo/day/year) 12/10/08 under the business name of Larsen and Associates, Inc. by (signature) _____

INSTRUCTIONS: Please fill in blanks or circle the correct answers. Send top three copies to Kansas Department of Health and Environment, Bureau of Water, Geology Section, 1000 SW Jackson St., Ste. 420, Topeka, Kansas 66612-1367. Telephone: 785/296-5522. Send one to Water Well Owner and retain one for your records. Visit us at <http://www.kdheks.gov/waterwell>.