

WATER WELL RECORD

Form WWC-5


Division of Water Resources App. No.

1 LOCATION OF WATER WELL: County: Phillips Fraction NW 1/4 NW 1/4 SW 1/4 Section Number 27 Township No. T 3 S Range Number R 16

Street/Rural Address of Well Location; if unknown, distance & direction from nearest town or intersection: 75' west on the southside of road from Main St. & Railroad Ave. in the town of Agra, KS

2 WATER WELL OWNER: Pro-Aq Marketing RR#, Street Address, Box #: 671 Railroad Ave City, State, ZIP Code : Agra. KS 67621

Global Positioning System (GPS) information: Latitude: Longitude: Elevation: Datum: Collection Method: Est. Accuracy:

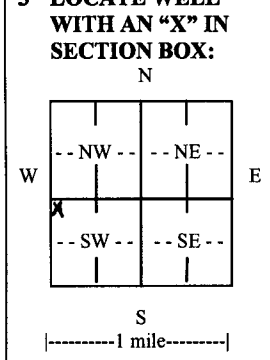

3 LOCATE WELL WITH AN 'X' IN SECTION BOX: 4 DEPTH OF COMPLETED WELL 62.5 ft. Depth(s) Groundwater Encountered (1) 1 ft. (2) ft. (3) ft. WELL'S STATIC WATER LEVEL 45.01 ft. below land surface measured on mo/day/yr. 8/21/09

5 TYPE OF CASING USED: Steel PVC Other CASING JOINTS: Glued Clamped Welded Threaded

Casing diameter 2 in. to 55.5 ft., Diameter in. to ft., Diameter in. to ft. Casing height above land surface 36 in., Weight SCH40 lbs./ft., Wall thickness or gauge No.

TYPE OF SCREEN OR PERFORATION MATERIAL: Steel Stainless Steel PVC Other (Specify) Brass Galvanized Steel None used (open hole)

SCREEN OR PERFORATION OPENINGS ARE: Continuous slot Mill slot Gauze wrapped Torch cut Drilled holes None (open hole) Louvered shutter Key punched Wire wrapped Saw cut Other (specify)

SCREEN-PERFORATED INTERVALS: From 62.5 ft. to 52.5 ft., From ft. to ft., From ft. to ft.

GRAVEL PACK INTERVALS: From 62.5 ft. to 50.5 ft., From ft. to ft., From ft. to ft.

6 GROUT MATERIAL: Neat cement Cement grout Bentonite Other Grout Intervals: From 50.5 ft. to 2 ft., From ft. to ft., From ft. to ft.

What is the nearest source of possible contamination: Septic tank Lateral lines Pit privy Livestock pens Insecticide storage Other (specify below) Sewer lines Cesspool Sewage lagoon Fuel storage Abandoned water well Grain Elevators Watertight sewer lines Seepage pit Feedyard Fertilizer storage Oil well/gas well

Table with columns: FROM, TO, LITHOLOGIC LOG, FROM, TO, LITHO. LOG (cont.) or PLUGGING INTERVALS. Rows include Topsoil, Silt SAA much roots, Silt SAA clay brn moist silty, Clayey SAA few macropores, Sand vf-m much silt&clay&pebbles, Sand SAA w/sand streaks top, Silt SAA less sand w/caliche, Silt tan much clay firm moist silt, Silt SAA moist, Silt SAA moist w/wet streaks salt.

7 CONTRACTOR'S OR LANDOWNER'S CERTIFICATION: This water well was constructed, reconstructed, or plugged under my jurisdiction and was completed on (mo/day/year) 8/21/09 and this record is true to the best of my knowledge and belief. Kansas Water Well Contractor's License No. 665 This Water Well Record was completed on (mo/day/year) 9/10/09 under the business name of Pratt Well Service, Inc. by (signature) [Signature]

INSTRUCTIONS: Use typewriter or ball point pen. PLEASE PRESS FIRMLY and PRINT clearly. Please fill in blanks and check the correct answers. Send three copies (white, blue, pink) to Kansas Department of Health and Environment, Bureau of Water, Geology Section, 1000 SW Jackson St., Suite 420, Topeka, Kansas 66612-1367. Telephone 785-296-5522. Send one copy to WATER WELL OWNER and retain one for your records. Include fee of \$5.00 for each constructed well. Visit us at http://www.kdheks.gov/waterwell/index.html.