

WATER WELL RECORD

Form WWC-5


Division of Water Resources App. No.

1 LOCATION OF WATER WELL: County: Phillips, Fraction: NC 1/4 NW 1/4 SW 1/4, Section Number: 27, Township No.: T 3 S, Range Number: R 16

Street/Rural Address of Well Location; if unknown, distance & direction from nearest town or intersection: From the intersection of Main Street and Railroad Ave. go 300' east and 75' north.

2 WATER WELL OWNER: Pro-Aq Marketing, RR#, Street Address, Box #: 671 Railroad Ave., City, State, ZIP Code: Agra, KS 67621

Global Positioning System (GPS) information: Latitude, Longitude, Elevation, Datum, Collection Method

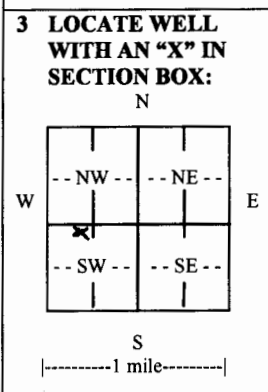

3 LOCATE WELL WITH AN 'X' IN SECTION BOX: 4 DEPTH OF COMPLETED WELL 69 ft. Depth(s) Groundwater Encountered, WELL'S STATIC WATER LEVEL, Pump test data, EST. YIELD, Bore Hole Diameter, WELL WATER TO BE USED AS, Was a chemical/bacteriological sample submitted to Department?

5 TYPE OF CASING USED: Steel, PVC, Other. CASING JOINTS: Glued, Clamped, Welded, Threaded. Casing diameter, Casing height above land surface, TYPE OF SCREEN OR PERFORATION MATERIAL, SCREEN OR PERFORATION OPENINGS ARE, SCREEN-PERFORATED INTERVALS, GRAVEL PACK INTERVALS

6 GROUT MATERIAL: Neat cement, Cement grout, Bentonite, Other sand. Grout Intervals, What is the nearest source of possible contamination: Septic tank, Lateral lines, Pit privy, Livestock pens, Insecticide storage, Other (specify below)

Table with columns: FROM, TO, LITHOLOGIC LOG, FROM, TO, LITHO. LOG (cont.) or PLUGGING INTERVALS. Rows describe geological layers from 0' to 64' depth.

7 CONTRACTOR'S OR LANDOWNER'S CERTIFICATION: This water well was constructed, reconstructed, or plugged under my jurisdiction and was completed on (mo/day/year) 10/27/09 and this record is true to the best of my knowledge and belief.

INSTRUCTIONS: Use typewriter or ball point pen. PLEASE PRESS FIRMLY and PRINT clearly. Please fill in blanks and check the correct answers. Send three copies (white, blue, pink) to Kansas Department of Health and Environment, Bureau of Water, Geology Section, 1000 SW Jackson St., Suite 420, Topeka, Kansas 66612-1367.