


1 LOCATION OF WATER WELL: Fraction ¼ SE ¼ SE ¼ SW ¼ Section Number 27 Township Number T 3 S Range Number 16 E W
 County: Phillips

Street/Rural Address of Well Location; if unknown, distance & direction from nearest town or intersection: If at owner's address, check here 819 Frontage Road, Agra

Global Positioning Systems (GPS) information:
 Latitude: 39.756738 (in decimal degrees)
 Longitude: 99.115590 (in decimal degrees)
 Elevation: _____
 Horizontal Datum: WGS84, NAD83, NAD27
 Collection Method: _____
 GPS unit (Make/Model: _____)
 Digital Map/Photo, Topographic Map, Land Survey
 Est. Accuracy: < 3 m, 3-5 m, 5-15 m, > 15 m

2 WATER WELL OWNER: Farmer's National Bank
 RR#, St. Address, Box #: P O Box 546
 City, State ZIP Code: Phillipsburg, KS 67661

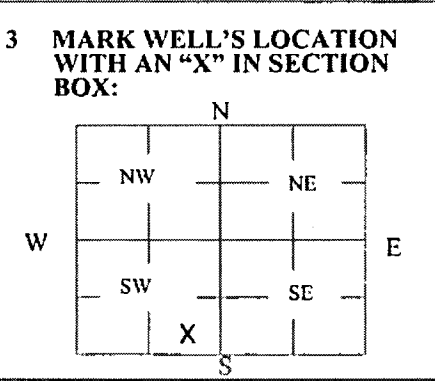

4 DEPTH OF WELL 47.60 **ft.**
WELL'S STATIC WATER LEVEL 35.40 **ft**
WELL WAS USED AS:
 Domestic Public Water Supply Dewatering
 Irrigation Oil Field Water Supply Monitoring IW-16
 Feedlot Domestic (Lawn & Garden) Injection Well
 Industrial Air Conditioning Other _____
 Was a chemical/bacteriological sample submitted to Department? Yes No

5 TYPE OF BLANK CASING USED:
 Steel RMP (SR) Wrought Fiberglass Other (Specify below)
 PVC ABS Asbestos-Cement Concrete Tile
 Blank casing diameter 1 in. Was casing pulled? Yes No If yes, how much approx 2'
 Casing height above or below land surface 24 in.

6 GROUT PLUG MATERIAL: Neat cement Cement grout Bentonite Other _____
 Grout Plug Intervals: From 2 ft. to 47.60 ft., From _____ ft. to _____ ft., From _____ ft. to _____ ft.

What is the nearest source of possible contamination:
 Septic tank Seepage pit Fuel storage Other (specify below)
 Sewer lines Pit privy Fertilizer storage
 Watertight sewer lines Sewage lagoon Insecticide storage
 Lateral lines Feedyard Abandoned water well Direction from well? _____
 Cess pool Livestock pens Oil well/Gas well How many feet? _____

FROM	TO	PLUGGING MATERIALS	FROM	TO	PLUGGING MATERIALS
0	2	Native Soil			
2	47.60	Bentonite Grout			
					Shamrock Service site U6-074-00224

7 CONTRACTOR'S OR LANDOWNER'S CERTIFICATION: This water well was plugged under my jurisdiction and was completed on (mo/day/year) 10/18/18 and this record is true to the best of my knowledge and belief. Kansas Water Well Contractor's License No. 735. This Water Well Record was completed on (mo/day/year) 10/24/18 under the business name of MILCO Environmental Services, Inc. by (signature) [Signature]

Send one white copy to Kansas Department of Health & Environment, Geology Section, 1000 SW Jackson Street, Ste. 420, Topeka, KS 66612-1367. Send one copy to WATER WELL OWNER and retain one for your records.
 Visit us at <http://www.kdheks.gov/waterwell/index.html> Telephone 785-296-5524.



MILCO

Environmental Services, Inc.

October 26, 2018

320 West 4th Street
Colby, KS 67701
Tel: 785-460-1956
Fax: 785-460-4220
www.milcoinc.com

Kansas Department of Health and Environment
Bureau of Water - GWTS
1000 SW Jackson St, Ste 420
Topeka, KS 66612-1367

RE: Shamrock Services
819 Frontage Road, Agra, KS
KDHE Project Code: U6-074-00224
MILCO Project Number: M287-P1-14

Dear Sir or Madam:

Please find enclosed sixteen (16) Water Well Plugging Records WWC-5PS for the Former Shamrock Services site in Agra, KS. The wells were abandoned by MILCO Environmental Services on October 18, 2018.

If you need any additional information, please don't hesitate to contact us.

Respectfully submitted,
MILCO Environmental Services, Inc.



Kathy Wheelbarger

KJW/

Enclosures

RECEIVED
OCT 30 2018
BUREAU OF WATER