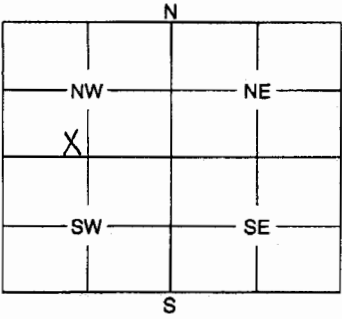


1	LOCATION OF WATER WELL:	Fraction	Section Number	Township Number	Range Number
County:	Phillips	SE ¼ SW ¼ NW ¼	26	3 S	17 <span style="border: 1px solid black; border-radius: 50%; padding: 2px;">EW</span>

Distance and direction from nearest town or city street address of well if located within city?

South side of Railroad Ave. at Main Street, Gretna

2	WATER WELL OWNER: RANGELAND COOP, INC. 250 F Street RR #, St. Address, Box #: PO Box 624 City, State, ZIP Code : Phillipsburg, KS 67661	Board of Agriculture, Division of Water Resources Application Number:
---	--	--

3	MARK WELL'S LOCATION WITH AN "X" IN SECTION BOX: 	4	DEPTH OF WELL ..... 44.75 ..... ft. WELL'S STATIC WATER LEVEL ..... 39.45 ..... ft. WELL WAS USED AS: 1 Domestic                      5 Public Water Supply                      9 Dewatering 2 Irrigation                      6 Oil Field Water Supply                      ● Monitoring Well 3 Feedlot                          7 Domestic (Lawn & Garden)                      11 Injection Well 4 Industrial                      8 Air Conditioning                          12 Other .....
---	--	---	---

Was a chemical / bacteriological sample submitted to Department? Yes ..... No .....  .....  
If yes, mo/day/yr sample was submitted .....

Water Well Disinfected: Yes ..... No .....  .....

5	TYPE OF BLANK CASING USED: 1 Steel                      3 RMP (SR)                      5 Wrought                      7 Fiberglass                      9 Other (Specify below) ● PVC                      4 ABS                      6 Asbestos-Cement                      8 Concrete Tile .....
---	---

Blank casing diameter ..... 2 ..... in.                      Was casing pulled?                      Yes .....                      No .....  .....                      If yes, how much .....

Casing height above or below land surface ..... N/A ..... in.

6	GROUT PLUG MATERIAL:                      1 Neat cement                      2 Cement grout                      ● Bentonite                      ● Other ..Native soil.....
---	--

Grout Plug Intervals:                      From ..... 0 ..... ft.                      to ..... 3 ..... ft.,                      From ..... 3 ..... ft.                      to ..... 44.75 ..... ft.,                      From ..... to .....

What is the nearest source of possible contamination:  
1 Septic tank                      6 Seepage pit                      11 Fuel storage                      16 Other (specify below)  
2 Sewer lines                      7 Pit privy                      12 Fertilizer storage  
3 Watertight sewer lines                      8 Sewage lagoon                      13 Insecticide storage  
4 Lateral lines                      9 Feedyard                      14 Abandoned water well  
5 Cess pool                      10 Livestock pens                      15 Oil well/Gas well

Direction from well? .....                      How many feet? .....

FROM	TO	PLUGGING MATERIALS
0	3	Native soil
3	44.75	Bentonite (2")

Casing removed to 3' bgs  
MW8  
GeoCore #1377

7	CONTRACTOR'S OF LANDOWNER'S CERTIFICATION: This water well was plugged under my jurisdiction and was completed on (mo/day/year) ..... 3/29/2007 ..... and this record is true to the best of my knowledge and belief. Kansas Water Well Contractor's License No. .... 527 ..... This Water Well Record was completed on (mo/day/year) ..... 4/11/2007 ..... under the business name of Geocore Inc. .... by (signature) ..... <i>Don R...</i> .....
---	--

INSTRUCTIONS: Use typewriter or ball point pen. Please press firmly and print clearly. Please fill in blanks, underline or circle the correct answers. Send top three copies to Kansas Department of Health and Environment, Bureau of Water, Geology Section, 1000 SW Jackson St., Ste. 420, Topeka, Kansas 66612-1367. Telephone: 785/296-5522. Send one to Water Well Owner and retain one for your records.