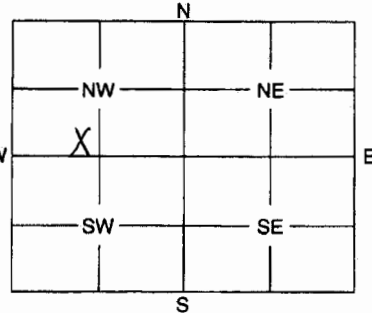


1	LOCATION OF WATER WELL:	Fraction	Section Number	Township Number	Range Number
	County: Phillips	SE 1/4 SW 1/4 NW 1/4	26	3 S	17 <span style="float:right; border: 1px solid black; border-radius: 50%; padding: 2px;">EW</span>

Distance and direction from nearest town or city street address of well if located within city?

South side of Railroad Ave. at Main Street, Gretna

2	WATER WELL OWNER: RANGELAND COOP, INC. 250 F Street RR #, St. Address, Box #: PO Box 624 City, State, ZIP Code : Phillipsburg, KS 67661	Board of Agriculture, Division of Water Resources Application Number:
---	--	--

3 MARK WELL'S LOCATION WITH AN "X" IN SECTION BOX:  	4 DEPTH OF WELL ..... 43.75 ..... ft.  WELL'S STATIC WATER LEVEL ..... 38.43 ..... ft.  WELL WAS USED AS:  <table style="width:100%; border:none;"> <tr> <td style="width:33%;">1 Domestic</td> <td style="width:33%;">5 Public Water Supply</td> <td style="width:33%;">9 Dewatering</td> </tr> <tr> <td>2 Irrigation</td> <td>6 Oil Field Water Supply</td> <td><input checked="" type="radio"/> Monitoring Well</td> </tr> <tr> <td>3 Feedlot</td> <td>7 Domestic (Lawn &amp; Garden)</td> <td>11 Injection Well</td> </tr> <tr> <td>4 Industrial</td> <td>8 Air Conditioning</td> <td>12 Other .....</td> </tr> </table> <p>Was a chemical / bacteriological sample submitted to Department? Yes ..... No <input checked="" type="checkbox"/>.....                  If yes, mo/day/yr sample was submitted .....</p> <p>Water Well Disinfected: Yes .

5	TYPE OF BLANK CASING USED:	1 Steel      3 RMP (SR)      5 Wrought      7 Fiberglass      9 Other (Specify below) <input checked="" type="radio"/> PVC      4 ABS      6 Asbestos-Cement      8 Concrete Tile
	Blank casing diameter ..... 2 ..... in.	Was casing pulled? Yes ..... No <input checked="" type="checkbox"/> ..... If yes, how much .....
	Casing height above or below land surface ..... N/A ..... in.	

6	GROUT PLUG MATERIAL:	1 Neat cement      2 Cement grout <input checked="" type="radio"/> Bentonite <input checked="" type="radio"/> Other ..Native soil.....															
	GROUT PLUG INTERVALS:	From ..... 0 ..... ft. to ..... 3 ..... ft., From ..... 3 ..... ft. to ..... 43.75 ..... ft., From ..... to ..... ft.															
	What is the nearest source of possible contamination:	<table style="width:100%; border:none;"> <tr> <td style="width:33%;">1 Septic tank</td> <td style="width:33%;">6 Seepage pit</td> <td style="width:33%;">11 Fuel storage</td> </tr> <tr> <td>2 Sewer lines</td> <td>7 Pit privy</td> <td>12 Fertilizer storage</td> </tr> <tr> <td>3 Watertight sewer lines</td> <td>8 Sewage lagoon</td> <td>13 Insecticide storage</td> </tr> <tr> <td>4 Lateral lines</td> <td>9 Feedyard</td> <td>14 Abandoned water well</td> </tr> <tr> <td>5 Cess pool</td> <td>10 Livestock pens</td> <td>15 Oil well/Gas well</td> </tr>
	Direction from well? .....	How many feet? .....															

FROM	TO	PLUGGING MATERIALS
0	3	Native soil
3	43.75	Bentonite (2")

Casing removed to 3' bgs  
  
MW10  
  
GeoCore #1377

7	CONTRACTOR'S OF LANDOWNER'S CERTIFICATION: This water well was plugged under my jurisdiction and was completed on (mo/day/year) ..... 3/29/2007 ..... and this record is true to the best of my knowledge and belief. Kansas Water Well Contractor's License No. .... 527 ..... This Water Well Record was completed on (mo/day/year) ..... 4/11/2007 ..... under the business name of GeoCore, Inc. .... by (signature) ..... <i>John R. Bell</i> .....
---	---

INSTRUCTIONS: Use typewriter or ball point pen. Please press firmly and print clearly. Please fill in blanks, underline or circle the correct answers. Send top three copies to Kansas Department of Health and Environment, Bureau of Water, Geology Section, 1000 SW Jackson St., Ste. 420, Topeka, Kansas 66612-1367. Telephone: 785/296-5522. Send one to Water Well Owner and retain one for your records.