


1 LOCATION OF WATER WELL: County: Phillips Fraction: SE 1/4 NW 1/4 SE 1/4 Section Number: 30 Township Number: T 3 S Range Number: R 17 EW  
 Distance and direction from nearest town or city street address of well if located within city?  
SE Phillipsburg 2 1/2 miles

2 WATER WELL OWNER: RR#, St. Address, Box #: Wave Boyle 67661  
 City, State, ZIP Code: Rt 3 Phillipsburg Kansas Board of Agriculture, Division of Water Resources  
 Application Number:

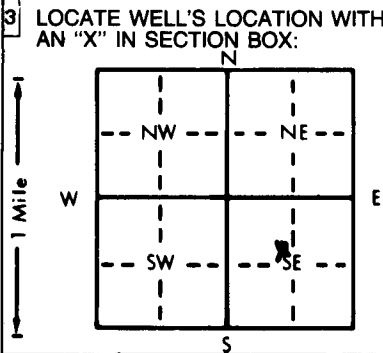

4 DEPTH OF COMPLETED WELL: 89' ft. ELEVATION: ..... ft.  
 Depth(s) Groundwater Encountered 1. 45' ft. 2. 89' ft. 3. .... ft.  
 WELL'S STATIC WATER LEVEL 45' ft. below land surface measured on mo/day/yr 5-27-87  
 Pump test data: Well water was 45' ft. after 3.7 hours pumping 10 gpm  
 Est. Yield 15 gpm: Well water was ..... ft. after ..... hours pumping ..... gpm  
 Bore Hole Diameter: 10 1/2 in. to 89' ft., and ..... in. to ..... ft.  
 WELL WATER TO BE USED AS:  
 1 Domestic  3 Feedlot  6 Oil field water supply  9 Dewatering  12 Other (Specify below)  
 2 Irrigation  4 Industrial  7 Lawn and garden only  10 Observation well  
 Was a chemical/bacteriological sample submitted to Department? Yes.....No X.....; If yes, mo/day/yr sample was submitted  
 Water Well Disinfected? Yes X No

5 TYPE OF BLANK CASING USED:  
 1 Steel  3 RMP (SR)  5 Wrought iron  8 Concrete tile CASING JOINTS: Glued X Clamped .....  
 PVC  4 ABS  6 Asbestos-Cement  9 Other (specify below) Welded .....  
 7 Fiberglass ..... Threaded .....  
 Blank casing diameter 5" in. to 89' ft., Dia ..... in. to ..... ft., Dia ..... in. to ..... ft.  
 Casing height above land surface 2' in., weight 200# lbs./ft. Wall thickness or gauge No. 1/4  
 TYPE OF SCREEN OR PERFORATION MATERIAL:  
 PVC  10 Asbestos-cement  
 1 Steel  3 Stainless steel  5 Fiberglass  8 RMP (SR)  11 Other (specify) .....  
 2 Brass  4 Galvanized steel  6 Concrete tile  9 ABS  12 None used (open hole)  
 SCREEN OR PERFORATION OPENINGS ARE:  
 Continuous slot  3 Mill slot  5 Gauzed wrapped  8 Saw cut  11 None (open hole)  
 2 Louvered shutter  4 Key punched  6 Wire wrapped  9 Drilled holes  
 7 Torch cut  10 Other (specify) .....  
 SCREEN-PERFORATED INTERVALS: From 6.0 ft. to 89' ft., From ..... ft. to ..... ft.  
 From ..... ft. to ..... ft., From ..... ft. to ..... ft.  
 GRAVEL PACK INTERVALS: From 20 ft. to 89' ft., From ..... ft. to ..... ft.  
 From ..... ft. to ..... ft., From ..... ft. to ..... ft.

6 GROUT MATERIAL: 1 Neat cement 2 Cement grout 3 Bentonite 4 Other .....  
 Grout Intervals: From 0 ft. to 20' ft., From ..... ft. to ..... ft., From ..... ft. to ..... ft.  
 What is the nearest source of possible contamination:  
 1 Septic tank  4 Lateral lines  7 Pit privy  10 Livestock pens  14 Abandoned water well  
 2 Sewer lines  5 Cess pool  8 Sewage lagoon  11 Fuel storage  15 Oil well/Gas well  
 3 Watertight sewer lines  6 Seepage pit  9 Feedyard  12 Fertilizer storage  16 Other (specify below)  
 13 Insecticide storage .....  
 Direction from well? How many feet? 200' North

FROM	TO	LITHOLOGIC LOG	FROM	TO	LITHOLOGIC LOG
0	5	Bl soil			
5	35	Clay			
35	60	Small + Clay			
60	75	Small, pebbles			
75	85	Blue mud + gravel			
	89	shale			

7 CONTRACTOR'S OR LANDOWNER'S CERTIFICATION: This water well was (1) constructed, (2) reconstructed, or (3) plugged under my jurisdiction and was completed on (mo/day/year) 5-27-87 and this record is true to the best of my knowledge and belief. Kansas Water Well Contractor's License No. 229. This Water Well Record was completed on (mo/day/yr) 6-22-87 under the business name of Phillipsburg Drilling by (signature) Warren Palmer

INSTRUCTIONS: Use typewriter or ball point pen, PLEASE PRESS FIRMLY and PRINT clearly. Please fill in blanks, underline or circle the correct answers. Send top three copies to Kansas Department of Health and Environment, Division of Environment, Environmental Geology Section, Topeka, KS 66620. Send one to WATER WELL OWNER and retain one for your records.