

USE TYPEWRITER OR BALL POINT PEN-PRESS FIRMLY, PRINT CLEARLY.

WATER WELL RECORD  
KSA 82a-1201-1215


T R EW sec 1/4 1/4 1/4 No.

Kansas State Dept. Of Health  
(Water Well Contractors)  
Forbes-Bldg. 740  
Topeka, Kansas 66620

*Phil M.*

1 Location of well: County Phillips Township name ARCADE Fraction NE 1/4 SE 1/4 SE 1/4 Section number 30 Town number T-3-S Range number R-17-W

Distance and direction from nearest town or city: 2 miles East of 1/4 N of Phillipburg, Mo 1/2 N. 3 Owner of well: Farm Land Agriservices Inc  
Street address of well location if in city: Phillipburg, Mo 1/2 N. Address: P.O. Box Denison, Iowa

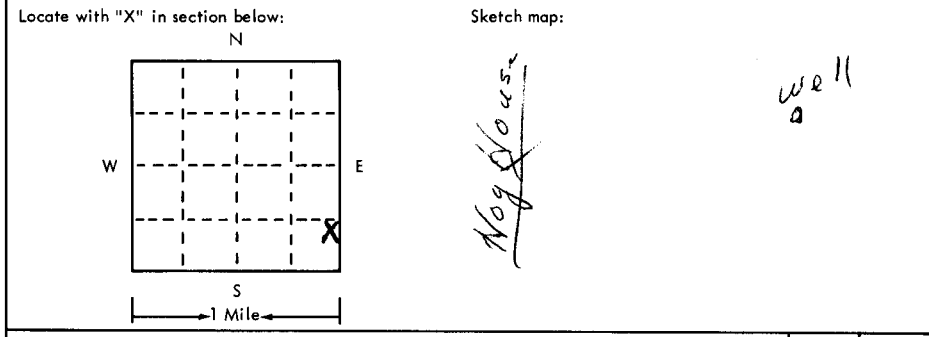

4 Well depth: 92 ft. Date of completion 8-3-79  
Well diameter 11 in.

5  Cable tool  Rotary  Driven  Dug  
 Hollow rod  Jetted  Bored  Reverse rotary

6 Use:  Domestic  Public supply  Industry  
 Irrigation  Air conditioning  Commercial  
 Test well

7 Casing: Material PLTS Height: above below  
Threaded  Welded  Surface 18 in.  
Diam. 5 in. to 92 ft. depth Drive shoe?  Yes  No  
5 in. to 92 ft. depth Weight 200 lbs./ft.

2	Type and color of material	From	To
	<u>Clay</u>	<u>0</u>	<u>20</u>
	<u>Clay Sand</u>	<u>20</u>	<u>50</u>
	<u>Broken Rock + Gravel</u>	<u>50</u>	<u>80</u>
	<u>Gravel + Blue Mud</u>	<u>80</u>	<u>92</u>
	<u>No bedrock?</u>		
	<u>1587</u>		

8 Screen: Manufacturer Pumped  
Type PVC Dia. 5"  
Slot/gauze 4/16 Length 20'  
Set between 72 ft. and 42 ft.  
Fittings: Gravel pack  Yes  No Size range of material 1/16

9 Static water level: 50 ft. below land surface Date 8-3-79

10 Pumping level below land surfaces:  
50 ft. after 4 hrs. pumping 90 g.p.m.  
15 ft. after 3 hrs. pumping 20 g.p.m.  
Estimated maximum yield 20 g.p.m.

11 Water sample submitted:  Yes  No Date \_\_\_\_\_

12 Well head completion:  Pitless adapter 18"  Inches above grade

13 Well grouted?  Yes  No  
 Neat cement  Bentonite  \_\_\_\_\_  
Depth: From 5 ft. to 15 ft.

14 Nearest source of possible contamination: 2000 ft. Direction South Type \_\_\_\_\_  
Well disinfected upon completion?  Yes  No

15 Pump:  Not installed  
Manufacturer's name Red Jacket  
Model number 30 HP 1 Volts 230  
Length of drop pipe 80 ft. capacity 30 g.m.p.  
Type:  Submersible  Turbine  
 Jet  Reciprocating  
 Centrifugal  Other

16 Remarks: elevation

Topography:  Hill  Slope  Upland  Valley

17 Water well contractor's certification:  
This well was drilled under my jurisdiction and this report is true to the best of my knowledge and belief.  
Redinger Well Inc 229  
Business name 388 St Phillipburg, Mo License No. \_\_\_\_\_  
Address Denison, Iowa  
Signed Daniel Redinger 8-3-79  
Authorized representative

3 17W 30 NE SE SE