


1 LOCATION OF WATER WELL: Fraction SW ¼ NW ¼ NE ¼ Section Number 26 Township Number T 3 S Range Number R 18 E/W

Distance and direction from nearest town or city street address of well if located within city?
 3 blks N of 'A' St. 1 Blk E by RR Trks, Phillipsbu

2 WATER WELL OWNER: Farmland Industries, Inc.
 RR#, St. Address, Box# : P.O. Box 7305, Dept. 141 Board of Agriculture, Division of Water Resources
 City, State, ZIP Code : Kansas City, Missouri 64116-0005 Application Number:

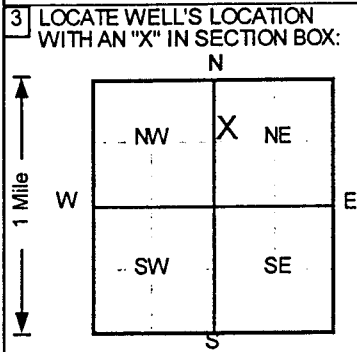

4 DEPTH OF COMPLETED WELL 49.5 ft ELEVATION: 999
 Depth(s) Groundwater Encountered 1. 36.9 ft 2. ft 3. ft
 WELL'S STATIC WATER LEVEL .999 ft below land surface measured on mo/day/yr
 Pump test data: Well water was NA ft after hours pumping gpm
 Est Yield NA gpm: Well water was ft after hours pumping gpm
 Bore Hole Diameter 8 in. to 49.5 ft, and in. to ft
 WELL WATER TO BE USED AS: 5 Public water supply 8 Air conditioning 11 Injection well
 1 Domestic 3 Feedlot 6 Oil field water supply 9 Dewatering 12 Other (Specify below)
 2 Irrigation 4 Industrial 7 Lawn and garden only 10 Monitoring well
 Was a chemical/bacteriological sample submitted to Department? Yes No ✓ If yes, mo/day/yr sample was submitted
 Water Well Disinfected? Yes No ✓

5 TYPE OF BLANK CASING USED: 5 Wrought iron 8 Concrete tile CASING JOINTS: Glued Clamped
 1 Steel 3 RMP (SR) 6 Asbestos-Cement 9 Other (specify below) Welded
 2 PVC 4 ABS 7 Fiberglass Threaded ✓
 Blank casing diameter 2 in. to 34 ft, Dia in. to ft, Dia in. to ft
 Casing height above land surface 0 in, weight Sch 40 lbs/ft Wall thickness or gauge No.
 TYPE OF SCREEN OR PERFORATION MATERIAL 7 PVC 10 Asbestos-cement
 1 Steel 3 Stainless steel 5 Fiberglass 8 RMP (SR) 11 Other (specify)
 2 Brass 4 Galvanized steel 6 Concrete tile 9 ABS 12 None used (open hole)
 SCREEN OR PERFORATION OPENINGS ARE: 5 Gauzed wrapped 8 Saw cut 11 None (open hole)
 1 Continuous slot 3 Mill slot 6 Wire wrapped 9 Drilled holes
 2 Louvered shutter 4 Key punched 7 Torch cut 10 Other (specify)
 SCREEN-PERFORATED INTERVALS: From 34 ft to 49 ft, From ft to ft
 From ft to ft, From ft to ft
 GRAVEL PACK INTERVALS: From 32 ft to 49.5 ft, From ft to ft
 From ft to ft, From ft to ft

6 GROUT MATERIAL: 1 Neat cement 2 Cement grout 3 Bentonite 4 Other
 Grout Intervals: From 0 ft to 2 ft, From 2 ft to 32 ft, From ft to ft
 What is the nearest source of possible contamination:
 1 Septic tank 4 Lateral lines 7 Pit privy 10 Livestock pens 14 Abandoned water well
 2 Sewer lines 5 Cess pool 8 Sewage lagoon 11 Fuel storage 15 Oil well/Gas well
 3 Watertight sewer lines 6 Seepage pit 9 Feedyard 12 Fertilizer storage 16 Other (specify below)
 Refinery
 Direction from well? How many feet? 0

FROM	TO	LITHOLOGIC LOG	FROM	TO	PLUGGING INTERVALS
0	0.5	Silt, Very Dark Brown			
0.5	7	Silt, Dark Yellow Brown			
7	9	Silt, Brown			
9	14.5	Silt, Dark Yellow Brown			
14.5	17	Silt, Dark Brown			
17	23	Silt, Yellow Brown			
23	24.9	Gravel, Yellow Brown			
24.9	31	Sand, Light Yellow Brown			
31	31.9	Gravel, Light Yellow Brown			
31.9	34	Clay, Light Yellow Brown			
34	49.5	Sand, Very Pale Brown			
					IM-10, Flushmount
					Project Name: Phillipsburg Refinery
					GeoCore # 138, #

7 CONTRACTOR'S OR LANDOWNER'S CERTIFICATION: This water well was (1) constructed, (2) reconstructed, or (3) plugged under my jurisdiction and was completed on (mo/day/year) 5/6/97 and this record is true to the best of my knowledge and belief.
 Kansas Water Well Contractor's License No. 527 This Water Well Record was completed on (mo/day/yr) 7-8-97
 under the business name of GeoCore Services, Inc. by (signature) Dale A. Roll