


1 LOCATION OF WATER WELL: Fraction NW ¼ NW ¼ NW ¼ Section Number 35 Township Number T 3 S Range Number R 18 **EW**

Distance and direction from nearest town or city street address of well if located within city?

195 State Street, Phillipsburg, Kansas

2 WATER WELL OWNER: J-J Oil Company  
 RR#, St. Address, Box # : Box 542 Board of Agriculture, Division of Water Resources  
 City, State, ZIP Code : Stockton, Kansas 67669 Application Number:

3 LOCATE WELL'S LOCATION WITH AN "X" IN SECTION BOX:

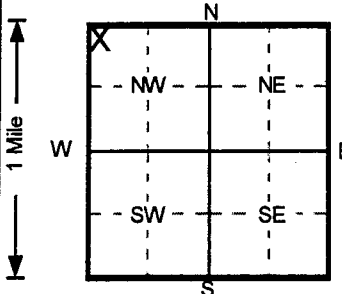

4 DEPTH OF COMPLETED WELL 70 ft. ELEVATION: 1945.96  
 Depth(s) Groundwater Encountered 1. ft. 2. ft. 3. ft.  
 WELL'S STATIC WATER LEVEL 59.14 ft. below land surface measured on mo/day/yr 10/29/98  
 Pump test data: Well water was NA ft. after hours pumping gpm  
 Est. Yield NA gpm: Well water was ft. after hours pumping gpm  
 Bore Hole Diameter 8 in. to 70 ft. and in. to ft.  
 WELL WATER TO BE USED AS: 5 Public water supply 8 Air conditioning 11 Injection well  
 1 Domestic 3 Feedlot 6 Oil field water supply 9 Dewatering 12 Other (Specify below)  
 2 Irrigation 4 Industrial 7 Lawn and garden only 10 Monitoring well  
 Was a chemical/bacteriological sample submitted to Department? Yes No  If yes, mo/day/yr sample was submitted  
 Water Well Disinfected? Yes No

5 TYPE OF BLANK CASING USED: 5 Wrought iron 8 Concrete tile CASING JOINTS: Glued Clamped  
 1 Steel 3 RMP (SR) 6 Asbestos-Cement 9 Other (specify below) Welded  
 2 PVC 4 ABS 7 Fiberglass Threaded   
 Blank casing diameter 2 in. to 50 ft. Dia. in. to ft. Dia. in. to ft.  
 Casing height above land surface -4.56 in., weight Sch 40 lbs./ft. Wall thickness or gauge No.  
 TYPE OF SCREEN OR PERFORATION MATERIAL 7 PVC 10 Asbestos-cement  
 1 Steel 3 Stainless steel 5 Fiberglass 8 RMP (SR) 11 Other (specify)  
 2 Brass 4 Galvanized steel 6 Concrete tile 9 ABS 12 None used (open hole)  
 SCREEN OR PERFORATION OPENINGS ARE: 3 Mill slot 11 None (open hole)  
 1 Continuous slot 2 Louvered shutter 4 Key punched 5 Gauzed wrapped 8 Saw cut 9 Drilled holes  
 6 Wire wrapped 7 Torch cut 10 Other (specify)  
 SCREEN-PERFORATED INTERVALS: From 50 ft. to 70 ft. From ft. to ft.  
 GRAVEL PACK INTERVALS: From 47 ft. to 70 ft. From ft. to ft.

6 GROUT MATERIAL: 1 Neat cement 2 Cement grout 3 Bentonite 4 Other  
 Grout Intervals: From 0 ft. to 42 ft. From 42 ft. to 47 ft. From ft. to ft.  
 What is the nearest source of possible contamination: 10 Livestock pens 14 Abandoned water well  
 1 Septic tank 4 Lateral lines 7 Pit privy 11 Fuel storage 15 Oil well/Gas well  
 2 Sewer lines 5 Cess pool 8 Sewage lagoon 12 Fertilizer storage 16 Other (specify below)  
 3 Watertight sewer lines 6 Seepage pit 9 Feedyard 13 Insecticide storage Former Tank Basin...  
 Direction from well? North How many feet? 350

FROM	TO	LITHOLOGIC LOG	FROM	TO	PLUGGING INTERVALS
0	0.5	Sand Gravel,			
0.5	4	Clay, Dark Brown			
4	17	Silt, Light Brown			
17	22	Clay, Light Brown			
22	25	Clay, Brown			
25	41	Clay, Light Brown-Red Brown			
41	57	Clay, Red Brown			
57	70	Sand, Light Brown			
					JMW14, Tag # 00274894, Flushmount
					Project Name: J-J Oil Co. #15
					GeoCore # 671, KDHE # U6 074 607

7 CONTRACTOR'S OR LANDOWNER'S CERTIFICATION: This water well was (1) constructed, (2) reconstructed, or (3) plugged under my jurisdiction and was completed on (mo/day/year) 10/28/98 and this record is true to the best of my knowledge and belief.  
 Kansas Water Well Contractor's License No. 527 This Water Well Record was completed on (mo/day/yr) 11/18/98  
 under the business name of GeoCore Services, Inc. by (signature) *Rob a Roll*

OFFICE USE ONLY  
T  
R  
EW  
SEC  
1/4  
1/4  
1/4