


1 LOCATION OF WATER WELL: Fraction NW 1/4 NW 1/4 NW 1/4 Section Number 35 Township Number T 3 S Range Number R 18

Distance and direction from nearest town or city street address of well if located within city? 195 State Street, Phillipsburg, Kansas

2 WATER WELL OWNER: J-J Oil Company RR#, St. Address, Box #: Box 542 City, State, ZIP Code: Stockton, Kansas 67669 Board of Agriculture, Division of Water Resources Application Number:

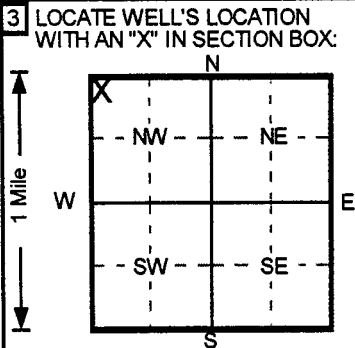

4 DEPTH OF COMPLETED WELL: 70 ft. ELEVATION: 1946.07. WELL'S STATIC WATER LEVEL: 59.04 ft. below land surface measured on 10/29/98. Pump test data: Well water was NA ft. after ... hours pumping ... gpm. Est. Yield: NA gpm. Well water was ... ft. after ... hours pumping ... gpm. Bore Hole Diameter: 8 in. to 70 ft. and ... in. to ... ft. WELL WATER TO BE USED AS: 5 Public water supply, 8 Air conditioning, 11 Injection well, 1 Domestic, 3 Feedlot, 6 Oil field water supply, 9 Dewatering, 12 Other (Specify below), 2 Irrigation, 4 Industrial, 7 Lawn and garden only, 10 Monitoring well. Was a chemical/bacteriological sample submitted to Department? Yes... No... If yes, mo/day/yr sample was submitted. Water Well Disinfected? Yes No

5 TYPE OF BLANK CASING USED: 1 Steel, 2 PVC, 3 RMP (SR), 4 ABS, 5 Wrought iron, 6 Asbestos-Cement, 7 Fiberglass, 8 Concrete tile, 9 Other (specify below). CASING JOINTS: Glued, Clamped, Welded, Threaded. Blank casing diameter: 2 in. to 50 ft., Dia. in. to ... ft., Dia. in. to ... ft. Casing height above land surface: -5.52 in., weight Sch 40 lbs./ft. Wall thickness or gauge No. ...

TYPE OF SCREEN OR PERFORATION MATERIAL: 1 Steel, 2 Brass, 3 Stainless steel, 4 Galvanized steel, 5 Fiberglass, 6 Concrete tile, 7 PVC, 8 RMP (SR), 10 Asbestos-cement, 11 Other (specify), 12 None used (open hole).

SCREEN OR PERFORATION OPENINGS ARE: 1 Continuous slot, 2 Louvered shutter, 3 Mill slot, 4 Key punched, 5 Gauzed wrapped, 6 Wire wrapped, 7 Torch cut, 8 Saw cut, 9 Drilled holes, 10 Other (specify), 11 None (open hole).

SCREEN-PERFORATED INTERVALS: From 50 ft. to 70 ft., From ... ft. to ... ft. GRAVEL PACK INTERVALS: From 47 ft. to 70 ft., From ... ft. to ... ft.

6 GROUT MATERIAL: 1 Neat cement, 2 Cement grout, 3 Bentonite, 4 Other. Grout Intervals: From 0 ft. to 41 ft., From 41 ft. to 47 ft., From ... ft. to ... ft. What is the nearest source of possible contamination: 1 Septic tank, 2 Sewer lines, 3 Watertight sewer lines, 4 Lateral lines, 5 Cess pool, 6 Seepage pit, 7 Pit privy, 8 Sewage lagoon, 9 Feedyard, 10 Livestock pens, 11 Fuel storage, 12 Fertilizer storage, 13 Insecticide storage, 14 Abandoned water well, 15 Oil well/Gas well, 16 Other (specify below) Former Tank Basin. Direction from well? Northwest How many feet? 200

Table with columns: FROM, TO, LITHOLOGIC LOG, FROM, TO, PLUGGING INTERVALS. Rows include lithology: Clay, Dark Brown; Clay, Brown; Clay, Brown-Red Brown; Clay, Red Brown; Sand, Light Brown; Clay, light Brown. Includes project info: JMW12, Tag # 00274702, Flushmount; Project Name: J-J Oil Co. #15; GeoCore # 671, KDHE # U6 074 607.

7 CONTRACTOR'S OR LANDOWNER'S CERTIFICATION: This water well was (1) constructed, (2) reconstructed, or (3) plugged under my jurisdiction and was completed on (mo/day/year) 10/22/98 and this record is true to the best of my knowledge and belief. Kansas Water Well Contractor's License No. 527 This Water Well Record was completed on (mo/day/yr) 11/18/98 under the business name of GeoCore Services, Inc. by (signature) Oak a Bell