


1 LOCATION OF WATER WELL: County: Phillips Fraction NW 1/4 NW 1/4 NW 1/4 Section Number 35 Township Number T 3 S Range Number R 18

Distance and direction from nearest town or city street address of well if located within city? 195 State Street, Phillipsburg, Kansas

2 WATER WELL OWNER: J-J Oil Company RR#, St. Address, Box #: Box 542 City, State, ZIP Code: Stockton, Kansas 67669 Board of Agriculture, Division of Water Resources Application Number:

3 LOCATE WELL'S LOCATION WITH AN "X" IN SECTION BOX:

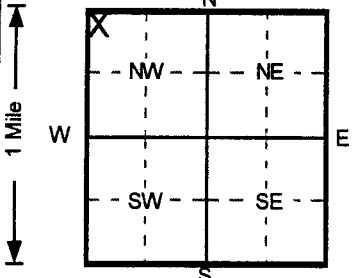

4 DEPTH OF COMPLETED WELL: 70 ft. ELEVATION: 1948.18. WELL'S STATIC WATER LEVEL: 60.65 ft. below land surface measured on 10/29/98. Pump test data: Well water was NA ft. after NA hours pumping. Est. Yield NA gpm. Bore Hole Diameter 8 in. to 70 ft. WELL WATER TO BE USED AS: 10 Monitoring well. Was a chemical/bacteriological sample submitted? Yes. Water Well Disinfected? Yes.

5 TYPE OF BLANK CASING USED: 2 PVC. Blank casing diameter 2 in. to 50 ft. Casing height above land surface -7.56 in., weight Sch 40. TYPE OF SCREEN OR PERFORATION MATERIAL: 7 PVC. SCREEN OR PERFORATION OPENINGS ARE: 3 Mill slot. SCREEN-PERFORATED INTERVALS: From 50 ft. to 70 ft. GRAVEL PACK INTERVALS: From 46 ft. to 70 ft.

6 GROUT MATERIAL: 2 Cement grout, 3 Bentonite. Grout Intervals: From 0 ft. to 41 ft., From 41 ft. to 46 ft. What is the nearest source of possible contamination: 16 Other (specify below) Former Tank Basin. Direction from well? Northeast. How many feet? 180.

Table with columns: FROM, TO, LITHOLOGIC LOG, FROM, TO, PLUGGING INTERVALS. Rows describe geological layers: Clay, Dark Brown; Clay, Light Brown; Clay, Brown; Clay, Light Brown-Light Red Brown; Clay, Red Brown; Clay, Red Brown; Sand, Light Brown. Includes project info: JMW13, Tag # 00274900, Flushmount; Project Name: J-J Oil Co. #15; GeoCore # 671, KDHE # U6 074 607.

7 CONTRACTOR'S OR LANDOWNER'S CERTIFICATION: This water well was (1) constructed, (2) reconstructed, or (3) plugged under my jurisdiction and was completed on (mo/day/year) 10/23/98 and this record is true to the best of my knowledge and belief. Kansas Water Well Contractor's License No. 527. This Water Well Record was completed on (mo/day/yr) 11/18/98 under the business name of GeoCore Services, Inc. by (signature) Dale A. Kohl

OFFICE USE ONLY T R EWM SEC. 1/4 1/4