


1 LOCATION OF WATER WELL: Fraction NW 1/4 NW 1/4 NW 1/4 Section Number 35 Township Number T 3 S Range Number R 18 E/W

Distance and direction from nearest town or city street address of well if located within city? 200 State Street, Phillipsburg, Kansas

2 WATER WELL OWNER: Gingerbread House Preschool RR#, St. Address, Box #: 369 Third Street City, State, ZIP Code: Phillipsburg, Kansas 67661 Board of Agriculture, Division of Water Resources Application Number:

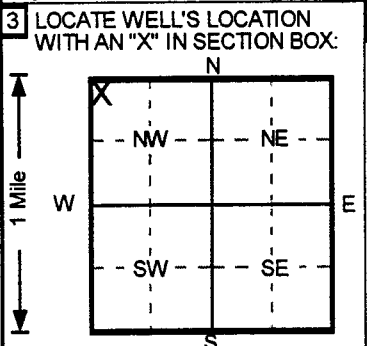

3 LOCATE WELL'S LOCATION WITH AN "X" IN SECTION BOX: 4 DEPTH OF COMPLETED WELL: 70 ft. ELEVATION: 1946.86 ft. WELL'S STATIC WATER LEVEL: 60.51 ft. below land surface measured on 10/29/98. Pump test data: Well water was NA ft. after hours pumping gpm. Est. Yield NA gpm: Well water was ft. after hours pumping gpm. Bore Hole Diameter 8 in. to 70 ft., and in. to ft. WELL WATER TO BE USED AS: 5 Public water supply 8 Air conditioning 11 Injection well 1 Domestic 3 Feedlot 6 Oil field water supply 9 Dewatering 12 Other (Specify below) 2 Irrigation 4 Industrial 7 Lawn and garden only 10 Monitoring well. Was a chemical/bacteriological sample submitted to Department? Yes No; If yes, mo/day/yr sample was submitted. Water Well Disinfected? Yes No

5 TYPE OF BLANK CASING USED: 1 Steel 2 PVC 3 RMP (SR) 4 ABS 5 Wrought iron 6 Asbestos-Cement 7 Fiberglass 8 Concrete tile 9 Other (specify below) CASING JOINTS: Glued Clamped Welded Threaded. Blank casing diameter 2 in. to 50 ft., Dia. Sch 40 lbs./ft. Wall thickness or gauge No. Casing height above land surface -4.32 in., weight. TYPE OF SCREEN OR PERFORATION MATERIAL: 1 Steel 2 Brass 3 Stainless steel 4 Galvanized steel 5 Fiberglass 6 Concrete tile 7 PVC 8 RMP (SR) 9 ABS 10 Asbestos-cement 11 Other (specify) 12 None used (open hole) SCREEN OR PERFORATION OPENINGS ARE: 1 Continuous slot 2 Louvered shutter 3 Mill slot 4 Key punched 5 Gauzed wrapped 6 Wire wrapped 7 Torch cut 8 Saw cut 9 Drilled holes 10 Other (specify) 11 None (open hole) SCREEN-PERFORATED INTERVALS: From 50 ft. to 70 ft. GRAVEL PACK INTERVALS: From 46 ft. to 70 ft.

6 GROUT MATERIAL: 1 Neat cement 2 Cement grout 3 Bentonite 4 Other Grout Intervals: From 0 ft. to 41 ft. From 41 ft. to 46 ft. What is the nearest source of possible contamination: 1 Septic tank 2 Sewer lines 3 Watertight sewer lines 4 Lateral lines 5 Cess pool 6 Seepage pit 7 Pit privy 8 Sewage lagoon 9 Feedyard 10 Livestock pens 11 Fuel storage 12 Fertilizer storage 13 Insecticide storage 14 Abandoned water well 15 Oil well/Gas well 16 Other (specify below) Former Tank Basin. Direction from well? North How many feet? 210

Table with columns: FROM, TO, LITHOLOGIC LOG, FROM, TO, PLUGGING INTERVALS. Data rows show intervals from 0 to 70 feet with lithological descriptions like Concrete, Clay, Brown, Silt, Light Brown, etc.

Table with columns: FROM, TO, LITHOLOGIC LOG, FROM, TO, PLUGGING INTERVALS. Data rows show intervals from 0 to 70 feet with lithological descriptions like Concrete, Clay, Brown, Silt, Light Brown, etc.

7 CONTRACTOR'S OR LANDOWNER'S CERTIFICATION: This water well was constructed, reconstructed, or plugged under my jurisdiction and was completed on (mo/day/year) 10/21/98 and this record is true to the best of my knowledge and belief. Kansas Water Well Contractor's License No. 527 This Water Well Record was completed on (mo/day/yr) 11/18/98 under the business name of GeoCore Services, Inc. by (signature) Dale A. Kelly