

# CORRECTION(S) TO WATER WELL RECORD (Form WWC-5)

(to rectify lacking or incorrect information)

<b>LOCATION OF WATER WELL:</b>	Fraction	Section	Township	Range
County: <u>Phillips</u>	<u>SE</u> $\frac{1}{4}$ <u>SW</u> $\frac{1}{4}$ <u>NE</u> $\frac{1}{4}$ <u>NE</u> $\frac{1}{4}$	<u>27</u>	T <u>3</u> S	R <u>18</u> <input type="checkbox"/> E <input checked="" type="checkbox"/> W

**Owner:** Coffeyville Resources Terminal

**Location was listed as:**

Sec. 27 T 3 S R 18 ☐ E ☒ W

Fraction: SE SW NE

**Location changed to:**

Sec. 27 T 3 S R 18 ☐ E ☒ W

Fraction: SE SW NE NE

**Other changes:** Initial statements: \_\_\_\_\_

Changed to: \_\_\_\_\_

Comments: Added Lat.: 39.76703155 Long.: -99.33133879 (IM-26)

Verification method: David Coe from WSP-Parsons Brinckerhoff obtained Latitude and Longitude from terminal head forman using GPS equipment

initials: DRL date: 05-10-2016

Submitted by: Kansas Geological Survey, Data Resources Library, 1930 Constant Ave., Lawrence, KS 66047-3726  
to: Kansas Dept of Health & Environment, Bureau of Water, 1000 SW Jackson, Suite 420, Topeka, KS 66612-1367.

FM-26

1 LOCATION OF WATER WELL: County: <b>PHILLIPS</b>	Fraction <b>SE</b> $\frac{1}{4}$ <b>SW</b> $\frac{1}{4}$ <del>NE</del> $\frac{1}{4}$	Section Number <b>27</b>	Township Number <b>T 3 S</b>	Range Number <b>R 18 E</b>
--	---	-----------------------------	---------------------------------	-------------------------------

Distance and direction from nearest town or city street address of well if located within city?

**NORTH HIGHWAY 183, PHILLIPSBURG, KS**

2 WATER WELL OWNER: RR#, St. Address, Box # : City, State, ZIP Code :	<b>COFFEYVILLE RESOURCES TERMINAL</b> <b>P.O. Box 608</b> <b>PHILLIPSBURG, KS 67661</b>	Board of Agriculture, Division of Water Resources Application Number:
---	---	--

3 LOCATE WELL'S LOCATION WITH AN "X" IN SECTION BOX:	4 DEPTH OF COMPLETED WELL ..... <b>50</b> ..... ft. ELEVATION: .....
---	--

AN "X" IN SECTION BOX:

N	
- NW -	- NE -
- X -	
- SW -	- SE -
S	

W                      E

Depth(s) Groundwater Encountered 1 ..... ft. 2 ..... ft. 3 ..... ft.

WELL'S STATIC WATER LEVEL ..... ft. below land surface measured on mo/day/yr .....

Pump test data: Well water was ..... ft. after ..... hours pumping ..... gpm

Est. Yield ..... gpm: Well water was ..... ft. after ..... hours pumping ..... gpm

WELL WATER TO BE USED AS:

1 Domestic	3 Feedlot	5 Public water supply	8 Air conditioning	11 Injection well
2 Irrigation	4 Industrial	6 Oil field water supply	9 Dewatering	12 Other (Specify below)
7 Domestic (lawn & garden) 10 Monitoring well .....				

Was a chemical/bacteriological sample submitted to Department? Yes ..... No ..... ; If yes, mo/day/yr sample was submitted

Water Well Disinfected? Yes ..... No

5 TYPE OF BLANK CASING USED:	5 Wrought iron	8 Concrete tile	CASING JOINTS: Glued ..... Clamped .....
1 Steel	6 Asbestos-Cement	9 Other (specify below)	Welded .....
<input checked="" type="radio"/> PVC	7 Fiberglass		Threaded <input checked="" type="checkbox"/>
Blank casing diameter ..... <b>2</b> ..... in. to <b>35</b> ..... ft. Dia ..... in. to ..... ft. Dia ..... in. to ..... ft.			
Casing height above land surface ..... <b>24</b> ..... in., weight <b>54</b> ..... lbs./ft. Wall thickness or gauge No. ....			
TYPE OF SCREEN OR PERFORATION MATERIAL:	<input checked="" type="radio"/> PVC	10 Asbestos-Cement	
1 Steel	8 RMP (SR)	11 Other (Specify) .....	
2 Brass	9 ABS	12 None used (open hole)	
3 Stainless Steel			
4 Galvanized Steel			
5 Fiberglass	8 Saw cut	11 None (open hole)	
6 Concrete tile	9 Drilled holes		
SCREEN OR PERFORATION OPENINGS ARE:	7 Torch cut	10 Other (specify) .....	
1 Continuous slot			
<input checked="" type="radio"/> Mill slot			
2 Louvered shutter			
4 Key punched			
SCREEN-PERFORATED INTERVALS: From ..... <b>50</b> ..... ft. to ..... <b>35</b> ..... ft. From ..... ft. to ..... ft.			
GRAVEL PACK INTERVALS: From ..... <b>50</b> ..... ft. to ..... <b>33</b> ..... ft. From ..... ft. to ..... ft.			

6 GROUT MATERIAL:	1 Neat cement	2 Cement grout	<input checked="" type="radio"/> Bentonite	4 Other .....
Grout Intervals: From ..... <b>33</b> ..... ft. to ..... <b>1.0</b> ..... ft. From ..... ft. to ..... ft. From ..... ft. to ..... ft.				
What is the nearest source of possible contamination:	10 Livestock pens	14 Abandoned water well		
1 Septic tank	11 Fuel storage	15 Oil well/Gas well		
2 Sewer lines	12 Fertilizer storage	16 Other (specify below)		
3 Watertight sewer lines	13 Insecticide storage			
4 Lateral lines				
5 Cess pool				
6 Seepage pit				
7 Pit privy				
8 Sewage lagoon				
9 Feedyard				
Direction from well?	How many feet?			

FROM	TO	LITHOLOGIC LOG	FROM	TO	PLUGGING INTERVALS
0	0.5	ORGANIC CLAY - TOPSOIL			
0.5	28	SILT - CLAYEY WITH SOME SAND, YELLOW BROWN			
28	30	SAND - MED. GRAINED, WELL SORTED, YELLOW BROWN			
30	32	SILT - BROWN			
32	42	SAND w/ SILT AND CLAY SEAMS			
42	44	SAND, GRAVELLY, DARK GRAY, POORLY SORTED			
44	50	CLAY SANDY TO SILTY, GRAY BROWN			

**RECEIVED**

**SEP 30 2004**

**BUREAU OF WATER**

7 CONTRACTOR'S OR LANDOWNER'S CERTIFICATION: This water well was (1) constructed, (2) reconstructed, or (3) plugged under my jurisdiction and was completed on (mo/day/year) ..... <b>7-22-04</b> ..... and this record is true to the best of my knowledge and belief. Kansas Water Well Contractor's Licence No ..... <b>529</b> ..... This Water Well Record was completed on (mo/day/yr) ..... <b>8-1-04</b> ..... under the business name of <b>GEO TECHNOLOGY, INC.</b> by (signature) <i>[Signature]</i>
---

Boring Log: IM-26

Project: Coffeyville - CRT

Project No.: 131018

Location: Phillipsburg


Completion Date: 7/22/04

Surface Elevation (feet AMSL\*): 1942.70

TOC Elevation (feet AMSL\*): 1945.82

Total Depth (feet): 50

Borehole Diameter (inches): 8.25

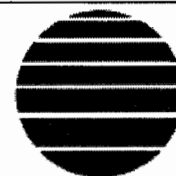

ENVIRONMENTAL  
STRATEGIES

Sample Data					Subsurface Profile	
Depth	Sample Interval	PID/OVM (ppm)	Blow Count	% Recovery	Lithology	Description
0						Ground Surface
						Organic Clay (OL)
2		0/0		91		Silt (ML) very stiff, 10YR5/3, low plasticity, dry
4						Clayey Silt (ML) medium stiff - stiff, 10YR5/4, low plasticity, dry, decreasing stiffness with depth
6		0/0		83		
8						
10		0/0		96		
12						
14		0/3		93		
16						Sandy, clayey, silt (ML) soft-medium stiff, 10YR3/2, low-med plasticity, moist
18		0/0		91		
20						

Well Construction

grout

RECEIVED

SEP 30 2004

BUREAU OF WATER

Geologist(s): Mike Haggerty  
Subcontractor: Geotechnology  
Driller/ Operator: Craig

Method: HSA ☒ ID(inches):  
Geoprobe ☐ Rotosonic ☐

\* AMSL= Above mean sea level

**Boring Log: IM-26****Project:** Coffeyville - CRT**Project No.:** 131018**Location:** Phillipsburg**Completion Date:** 7/22/04**Surface Elevation (feet AMSL\*):** 1942.70**TOC Elevation (feet AMSL\*):** 1945.82**Total Depth (feet):** 50**Borehole Diameter (inches):** 8.25
**ENVIRONMENTAL  
STRATEGIES**

Sample Data					Subsurface Profile	
Depth	Sample Interval	PID/OVM (ppm)	Blow Count	% Recovery	Lithology	Description
22		0/1		69		<b>Clayey silt (ML)</b> soft-medium stiff, 10YR4/3, low plasticity, moist, 2" sand seam at 27'
24						
26		0/0		87		
28						
30	0/0			87		<b>Sand (SW)</b> loose, 10YR6/4, well sorted, medium grained, sub angular
32						<b>Sandy, clayey, silt (ML)</b> soft-medium stiff, 10YR4/3, low plasticity, some larger pebble inclusions
34	0/0	29	50			<b>Sand (SW)</b> loose-med dense, 10YR5/3, medium grained, well sorted, sub angular, some gravel pieces
36	0/1	34	50			<b>Sandy, clayey silt seam (ML)</b> stiff, 10YR5/4, low plasticity
38	0/3	47	83			<b>Silty sand (SM)</b> dense, 10YR5/4, well sorted, small-med grained, subangular
40	13/6	51	63			<b>Sand (SW)</b> loose, 10YR 5/3, well sorted, medium grained, subangular

hydrated bentonite


**Geologist(s):** Mike Haggerty  
**Subcontractor:** Geotechnology  
**Driller/ Operator:** Craig

**Method:** HSA ☒ Geoprobe ☐  
**ID(inches):** Rotosonic ☐

\* AMSL = Above mean sea level

**Boring Log: IM-26****Project:** Coffeyville - CRT**Surface Elevation (feet AMSL\*):** 1942.70**Project No.:** 131018**TOC Elevation (feet AMSL\*):** 1945.82**Location:** Phillipsburg**Total Depth (feet):** 50**Completion Date:** 7/22/04**Borehole Diameter (inches):** 8.25

Sample Data					Subsurface Profile	
Depth	Sample Interval	PID/OVM (ppm)	Blow Count	% Recovery	Lithology	Description
42		43/82	24	67		
						<i>Clayey silt seam (ML)</i>
		13/100	13	100		<i>Gravelly, clayey sand (SG)</i> dense, 10YR4/1, poorly sorted, fine-large grains, angular grains
44		690/41	10	100		<i>Sandy clay (CL)</i> very stiff, 10YR5/2, low plasticity, some red/orange laminations
46		90/204	8	100		<i>Silty clay (CH)</i> medium stiff, 10YR5/3, medium plasticity, red/orange laminations
48		48/5	9	100		
50						
52						
54						
56						
58						
60						

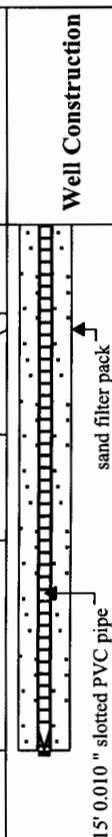**Geologist(s):** Mike Haggerty**Subcontractor:** Geotechnology**Driller/ Operator:** Craig**Method:** HSA ☒Geoprobe ☐**ID(inches):**Rotasonic ☐

\* AMSL = Above mean sea level