

# **CORRECTION(S) TO WATER WELL RECORD (Form WWC-5)**

(to rectify lacking or incorrect information)

<b>LOCATION OF WATER WELL:</b>	Fraction	Section	Township	Range
County: <u>Phillips</u>	<u>SW</u> $\frac{1}{4}$ <u>NE</u> $\frac{1}{4}$ <u>SE</u> $\frac{1}{4}$ <u>NE</u> $\frac{1}{4}$	<u>27</u>	T <u>3</u> S	R <u>18</u> <input type="checkbox"/> E <input checked="" type="checkbox"/> W

**Owner:** Coffeyville Resources Terminal

**Location was listed as:**

Sec. 27 T 3 S R 18 ☐E ☒W

Fraction: SW NE SE

**Location changed to:**

Sec. 27 T 3 S R 18 ☐E ☒W

Fraction: SW NE SE NE

**Other changes:** Initial statements: \_\_\_\_\_

Changed to: \_\_\_\_\_

Comments: Added Lat.: 39.76571861 Long.: -99.32943123 (IM-31)

Verification method: David Coe from WSP-Parsons Brinckerhoff obtained Latitude and Longitude from terminal head forman using

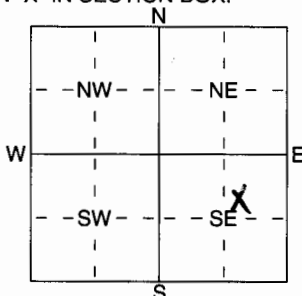
GPS equipment

initials: DRL date: 05-10-2016

Submitted by: Kansas Geological Survey, Data Resources Library, 1930 Constant Ave., Lawrence, KS 66047-3726  
to: Kansas Dept of Health & Environment, Bureau of Water, 1000 SW Jackson, Suite 420, Topeka, KS 66612-1367.

1 LOCATION OF WATER WELL: County: <b>PHILLIPS</b>	Fraction <b>SW 1/4 NE 1/4 SE 1/4</b>	Section Number <b>27</b>	Township Number <b>T 3 S</b>	Range Number <b>R 18 E/W</b>
--	---	-----------------------------	---------------------------------	---------------------------------

Distance and direction from nearest town or city street address of well if located within city?

**NORTH HIGHWAY 183, PHILLIPSBURG, KS**2 WATER WELL OWNER: **COFFEYVILLE RESOURCES TERMINAL**RR#, St. Address, Box # : **P.O. Box 608**  
City, State, ZIP Code : **PHILLIPSBURG, KS 67661**Board of Agriculture, Division of Water Resources  
Application Number:3 LOCATE WELL'S LOCATION WITH AN "X" IN SECTION BOX: 4 DEPTH OF COMPLETED WELL **54** ft. ELEVATION:

Depth(s) Groundwater Encountered 1 ..... ft. 2 ..... ft. 3 ..... ft.  
 WELL'S STATIC WATER LEVEL ..... ft. below land surface measured on mo/day/yr .....  
 Pump test data: Well water was ..... ft. after ..... hours pumping ..... gpm  
 Est. Yield ..... gpm: Well water was ..... ft. after ..... hours pumping ..... gpm  
 WELL WATER TO BE USED AS:  
 1 Domestic 3 Feedlot 5 Public water supply 8 Air conditioning 11 Injection well  
 2 Irrigation 4 Industrial 6 Oil field water supply 9 Dewatering 12 Other (Specify below)  
 7 Domestic (lawn & garden) 10 Monitoring well

Was a chemical/bacteriological sample submitted to Department? Yes ..... No ..... ; If yes, mo/day/yr sample was submitted  
 Water Well Disinfected? Yes ..... No

5 TYPE OF BLANK CASING USED:  
 1 Steel 3 RMP (SR) 5 Wrought iron 8 Concrete tile CASING JOINTS: Glued ..... Clamped .....  
 2 PVC 4 ABS 6 Asbestos-Cement 9 Other (specify below) Welded .....  
 7 Fiberglass Threaded **X**

Blank casing diameter **2** in. to **39** ft. Dia ..... in. to ..... ft. Dia ..... in. to ..... ft.  
 Casing height above land surface **0** in., weight **SCA 40** lbs./ft. Wall thickness or gauge No. ....

TYPE OF SCREEN OR PERFORATION MATERIAL:  
 1 Steel 3 Stainless Steel 5 Fiberglass 8 RMP (SR) 10 Asbestos-Cement  
 2 Brass 4 Galvanized Steel 6 Concrete tile 9 ABS 11 Other (Specify) .....  
 12 None used (open hole)

SCREEN OR PERFORATION OPENINGS ARE:  
 1 Continuous slot 3 Mill slot 5 Guazed wrapped 8 Saw cut 11 None (open hole)  
 2 Louvered shutter 4 Key punched 6 Wire wrapped 9 Drilled holes  
 7 Torch cut 10 Other (specify) ..... ft.

SCREEN-PERFORATED INTERVALS: From **54** ft. to **39** ft. From ..... ft. to ..... ft.  
 GRAVEL PACK INTERVALS: From **54** ft. to **37** ft. From ..... ft. to ..... ft.

6 GROUT MATERIAL: 1 Neat cement 2 Cement grout 3 Bentonite 4 Other .....  
 Grout Intervals: From **37** ft. to **1.0** ft. From ..... ft. to ..... ft. From ..... ft. to ..... ft.

What is the nearest source of possible contamination:  
 1 Septic tank 4 Lateral lines 7 Pit privy 10 Livestock pens 14 Abandoned water well  
 2 Sewer lines 5 Cess pool 8 Sewage lagoon 11 Fuel storage 15 Oil well/Gas well  
 3 Watertight sewer lines 6 Seepage pit 9 Feedyard 12 Fertilizer storage 16 Other (specify below)  
 13 Insecticide storage .....  
 Direction from well? How many feet?

FROM	TO	LITHOLOGIC LOG	FROM	TO	PLUGGING INTERVALS
0	0.5	ORGANIC CLAY - TOPSOIL			
0.5	32	SILT, CLAYEY, PALE TO YELLOW BROWN, LOW PLASTICITY			
32	34.5	SAND, YELLOW BROWN, MED. GRAINED, WELL SORTED			
34.5	40.5	SILT, CLAYEY, BROWN, LOW PLASTICITY			
40.5	45.5	CLAY, SANDY, DK. YELLOW BROWN MED. PLASTICITY			
45.5	48	SAND, GRAY, MED. GRAINED, WELL SORTED			
48	54	CLAY, YELLOW BROWN, HIGH PLASTICITY			

RECEIVED

SEP 30 2004

BUREAU OF WATER

7 CONTRACTOR'S OR LANDOWNER'S CERTIFICATION: This water well was (1) constructed, (2) reconstructed, or (3) plugged under my jurisdiction and was completed on (mo/day/year) **7-22-04** and this record is true to the best of my knowledge and belief. Kansas Water Well Contractor's Licence No **529** This Water Well Record was completed on (mo/day/yr) **7-27-04** under the business name of **GEOTECHNOLOGY, INC.** by (signature) *[Signature]*

**Boring Log: IM-31****Project:** Coffeyville - CRT**Project No.:** 131018**Location:** Phillipsburg**Completion Date:** 7/22/04**Surface Elevation (feet AMSL\*):** 1948.77**TOC Elevation (feet AMSL\*):** 1948.42**Total Depth (feet):** 54**Borehole Diameter (inches):** 8.25
**ENVIRONMENTAL  
STRATEGIES**

Sample Data					Subsurface Profile		Well Construction
Depth	Sample Interval	PID/OVM (ppm)	Blow Count	% Recovery	Lithology	Description	
0						Ground Surface	
						<i>Organic Clay (OL)</i>	
2		0/0		98		<i>Clayey silt (ML)</i> very stiff, 10YR6/3, low plasticity, dry	
4							
6		0/0		78			
8							
10		0/0		89		<i>Clayey, silt (ML)</i> stiff, 10YR6/3, low plasticity, dry	
12							
14		0/1		93			
16						<i>Sandy, clayey silt (ML)</i> very stiff, 10YR4/2, no-low plasticity, occasional sand grain	
18		0/0		93		<i>Clayey silt (ML)</i> very stiff, 10YR5/4, low plasticity, some white spot discoloration	
20							

**RECEIVED**  
**SEP 30 2004**  
**BUREAU OF WATER**

**Geologist(s):** Mike Haggerty  
**Subcontractor:** Geotechnology  
**Driller/ Operator:** Craig

**Method:** HSA ☒ ID(inches):  
 Geoprobe ☐ Rotosonic ☐

\* AMSL = Above mean sea level

**Boring Log: IM-31****Project:** Coffeyville - CRT**Project No.:** 131018**Location:** Phillipsburg**Completion Date:** 7/22/04**Surface Elevation (feet AMSL\*):** 1948.77**TOC Elevation (feet AMSL\*):** 1948.42**Total Depth (feet):** 54**Borehole Diameter (inches):** 8.25
**ENVIRONMENTAL  
STRATEGIES**

Sample Data					Subsurface Profile	
Depth	Sample Interval	PID/OVM (ppm)	Blow Count	% Recovery	Lithology	Description
22		0/1		85		
24						
26		0/1		89		<i>Sandy, clayey, silt (ML)</i> med stiff-stiff, 10YR5/6, low plasticity, dry, slight increase in sand content with depth
28						
30		0/1		96		
32						
34		0/1		93		<i>Sand (SW)</i> loose, 10YR6/4, small-med grained, well sorted, sub angular grains
36						
38		0/1		100		<i>Sandy, clayey silt (ML)</i> medium stiff, 10YR5/3, low plasticity, increase in sand content with depth, occasional red/orange discoloration spot
40						

Well Construction

hydrated bentonite

**Geologist(s):** Mike Haggerty  
**Subcontractor:** Geotechnology  
**Driller/ Operator:** Craig

**Method:** HSA ☒ ID(inches):  
 Geoprobe ☐ Rotosonic ☐

\* AMSL= Above mean sea level

**Boring Log: IM-31**

**Project:** Coffeyville - CRT

**Project No.:** 131018

**Location:** Phillipsburg

**Completion Date:** 7/22/04

**Surface Elevation (feet AMSL\*):** 1948.77

**TOC Elevation (feet AMSL\*):** 1948.42

**Total Depth (feet):** 54

**Borehole Diameter (inches):** 8.25



**ENVIRONMENTAL  
STRATEGIES**

Sample Data					Subsurface Profile	
Depth	Sample Interval	PID/OVM (ppm)	Blow Count	% Recovery	Lithology	Description
42		2/3		100		<b>Sandy clay (CL/CH)</b> very stiff, 10YR4/4, medium plasticity, moist
44						
46		366/178		80		<b>Sand (SW)</b> loose, gray, well sorted, medium grained, sub angular grains
48						<b>Clay (CH)</b> medium stiff, 10YR5/4, high plasticity, wet, some sand pebbles, red/orange discolorations
50		140/143	11	92		
52		4/7	3	100		
54		0/3	3	100		
56						
58						
60						

Well Construction

sand filter pack

15' 0.010" slotted PVC pipe

**Geologist(s):** Mike Haggerty  
**Subcontractor:** Geotechnology  
**Driller/ Operator:** Craig

**Method:** HSA ☒ ID(inches):  
 Geoprobe ☐ Rotosonic ☐

\* AMSL= Above mean sea level