


1 LOCATION OF WATER WELL: County: Phillips Fraction: NW 1/4 NW 1/4 SW 1/4 Section Number: 36 Township Number: T 3 S Range Number: R 18 EW

Distance and direction from nearest town or city street address of well if located within city? 1/2 mile south of Hwy 183 and Hwy 36 jet, east 1/4 mile

2 WATER WELL OWNER: DAVID & PAM INM RR#, St. Address, Box #: RT 3 City, State, ZIP Code: Phillipsburg, KS 67661 Board of Agriculture, Division of Water Resources Application Number:

3 LOCATE WELL'S LOCATION WITH AN "X" IN SECTION BOX: 4 DEPTH OF COMPLETED WELL: 52' ft. ELEVATION:

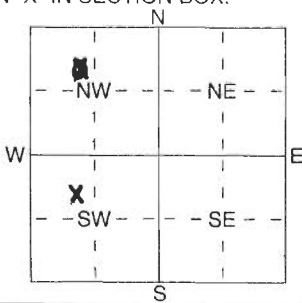

Depth(s) Groundwater Encountered: 1 ft. 2 ft. 3 ft. WELL'S STATIC WATER LEVEL: 30 ft. below land surface measured on mo/day/yr: 3-30-05 Pump test data: Well water was ... ft. after ... hours pumping ... gpm Est. Yield: 10 gpm: Well water was ... ft. after ... hours pumping ... gpm

WELL WATER TO BE USED AS: 5 Public water supply 8 Air conditioning 11 Injection well 7 Domestic 3 Feedlot 6 Oil field water supply 9 Dewatering 12 Other (Specify below) 2 Irrigation 4 Industrial 7 Domestic (lawn & garden) 10 Monitoring well Was a chemical/bacteriological sample submitted to Department? Yes No; If yes, mo/day/yr sample was submitted Water Well Disinfected? Yes No

5 TYPE OF BLANK CASING USED: 1 Steel 3 RMP (SR) 5 Wrought iron 8 Concrete tile CASING JOINTS: Glued Clamped 2 PVC 4 ABS 6 Asbestos-Cement 9 Other (specify below) Welded Threaded 7 Fiberglass

Blank casing diameter: 4 in. to 4 1/2 ft., Dia. Casing height above land surface: 2 in., weight lbs./ft. Wall thickness or gauge No.

TYPE OF SCREEN OR PERFORATION MATERIAL: 1 Steel 3 Stainless Steel 5 Fiberglass 8 RMP (SR) 10 Asbestos-Cement 2 Brass 4 Galvanized Steel 6 Concrete tile 9 ABS 11 Other (Specify) 12 None used (open hole)

SCREEN OR PERFORATION OPENINGS ARE: 1 Continuous slot 3 Mill slot 5 Gauzed wrapped 8 Saw cut 11 None (open hole) 2 Louvered shutter 4 Key punched 6 Wire wrapped 9 Drilled holes 10 Other (specify) 7 Torch cut

SCREEN-PERFORATED INTERVALS: From 52' ft. to 42' ft. GRAVEL PACK INTERVALS: From 52' ft. to 37' ft.

6 GROUT MATERIAL: 1 Neat cement 2 Cement grout 3 Bentonite 4 Other Grout Intervals: From 20 ft. to 0 ft., From 0 ft. to 0 ft., From 0 ft. to 0 ft., From 0 ft. to 0 ft.

What is the nearest source of possible contamination: 1 Septic tank 4 Lateral lines 7 Pit privy 10 Livestock pens 14 Abandoned water well 2 Sewer lines 5 Cess pool 8 Sewage lagoon 15 Oil well/Gas well 3 Watertight sewer lines 6 Seepage pit 9 Feedyard 12 Fertilizer storage 16 Other (specify below) 13 Insecticide storage

Direction from well? West How many feet? 150'

Table with columns: FROM, TO, LITHOLOGIC LOG, FROM, TO, PLUGGING INTERVALS. Rows contain handwritten data: 0-5 Black soil, 5-30 Clay, 30-37 Sand (Fine), 37-15 Sand & gravel, shale.

7 CONTRACTOR'S OR LANDOWNER'S CERTIFICATION: This water well was (1) constructed, (2) reconstructed, or (3) plugged under my jurisdiction and was completed on (mo/day/year) 3-20-05 and this record is true to the best of my knowledge and belief. Kansas Water Well Contractor's Licence No. 138 This Water Well Record was completed on (mo/day/yr) 3-20-2005 under the business name of Redinger Well Service by (signature) Amy Redinger