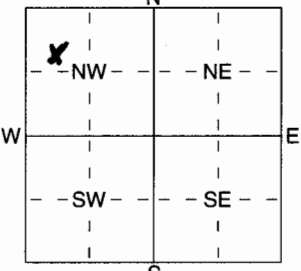


1 LOCATION OF WATER WELL: County: Phillips Fraction: SW 1/4 NW 1/4 NW 1/4 Section Number: 20 Township Number: T 3 S Range Number: R 18 E

Distance and direction from nearest town or city street address of well if located within city?
From Phillipsburg Mo. go west on 36 Hwy to W 300 Rd then north on 300 3/4 mile

2 WATER WELL OWNER: Gayland W. Dill
 RR#, St. Address, Box #: 1330 LEWIS LANE
 City, State, ZIP Code: Coleado Springs, CO 80915
 Board of Agriculture, Division of Water Resources
 Application Number:

3 LOCATE WELL'S LOCATION WITH AN "X" IN SECTION BOX:

 4 DEPTH OF COMPLETED WELL: 38 ft. ELEVATION:
 Depth(s) Groundwater Encountered: 16 ft. 2 ft. 3 ft.
 WELL'S STATIC WATER LEVEL ft. below land surface measured on 7-30-05
 Pump test data: Well water was ft. after hours pumping gpm
 Est. Yield: 8 gpm: Well water was ft. after hours pumping gpm
 WELL WATER TO BE USED AS:
 1 Domestic 3 Feedlot 6 Oil field water supply 9 Dewatering 12 Other (Specify below)
 2 Irrigation 4 Industrial 7 Domestic (lawn & garden) 10 Monitoring well Produce Well
 Was a chemical/bacteriological sample submitted to Department? Yes No ; If yes, mo/day/yrs sample was submitted
 Water Well Disinfected? Yes No

5 TYPE OF BLANK CASING USED:
 1 Steel 3 RMP (SR) 5 Wrought iron 8 Concrete tile CASING JOINTS: Glued Clamped
 2 PVC 4 ABS 6 Asbestos-Cement 9 Other (specify below) Welded
 7 Fiberglass Threaded
 Blank casing diameter: 6 in. to 20 ft., Dia in. to ft., Dia in. to ft.
 Casing height above land surface: 24 in., weight: 160 lbs./ft. Wall thickness or gauge No.
 TYPE OF SCREEN OR PERFORATION MATERIAL:
 1 Steel 3 Stainless Steel 5 Fiberglass 8 RMP (SR) 10 Asbestos-Cement
 2 Brass 4 Galvanized Steel 6 Concrete tile 9 ABS 11 Other (Specify)
 12 None used (open hole)
 SCREEN OR PERFORATION OPENINGS ARE:
 1 Continuous slot 3 Mill slot 5 Gauzed wrapped 8 Saw cut 11 None (open hole)
 2 Louvered shutter 4 Key punched 6 Wire wrapped 9 Drilled holes
 7 Torch cut 10 Other (specify) ft.
 SCREEN-PERFORATED INTERVALS: From 38 ft. to 20 ft., From ft. to ft.
 GRAVEL PACK INTERVALS: From 38 ft. to 20 ft., From ft. to ft.

6 GROUT MATERIAL: 1 Neat cement 2 Cement grout 3 Bentonite 4 Other
 Grout Intervals: From 20 ft. to 0 ft., From ft. to ft., From ft. to ft.
 What is the nearest source of possible contamination:
 1 Septic tank 4 Lateral lines 7 Pit privy 10 Livestock pens 14 Abandoned water well
 2 Sewer lines 5 Cess pool 8 Sewage lagoon 11 Fuel storage 15 Oil well/Gas well
 3 Watertight sewer lines 6 Seepage pit 9 Feedyard 12 Fertilizer storage 16 Other (specify below)
 13 Insecticide storage
 Direction from well? How many feet?

FROM	TO	LITHOLOGIC LOG	FROM	TO	PLUGGING INTERVALS
0	8	Top soil			
8	18	Clay			
18	36	Whiterock & gravel			
36	38	Shale (blue)			

7 CONTRACTOR'S OR LANDOWNER'S CERTIFICATION: This water well was (1) constructed, (2) reconstructed, or (3) plugged under my jurisdiction and was completed on (mo/day/year) 7-30-05 and this record is true to the best of my knowledge and belief. Kansas Water Well Contractor's Licence No. 738 This Water Well Record was completed on (mo/day/yr) 8-2-05 under the business name of Redhawk Well Service by (signature) [Signature]