


1 LOCATION OF WATER WELL: County: **PHILLIPS** Fraction: **SW 1/4 NE 1/4 SE 1/4** Section Number: **22** Township Number: **T 3 S** Range Number: **R 18 E**

Distance and direction from nearest town or city street address of well if located within city?
HIGHWAY 183 NORTH

2 WATER WELL OWNER: **COFFEYVILLE RESOURCES TERMINAL, LLC**
 RR#, St. Address, Box #: **HIGHWAY 183 NORTH** Board of Agriculture, Division of Water Resources
 City, State, ZIP Code: **PHILLIPSBURG, KS 67661** Application Number:

3 LOCATE WELL'S LOCATION WITH AN "X" IN SECTION BOX:

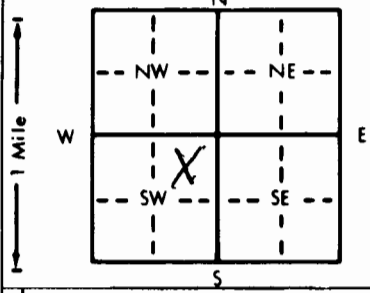

4 DEPTH OF COMPLETED WELL: **65** ft. ELEVATION:

Depth(s) Groundwater Encountered 1. ft. 2. ft. 3. ft.
 WELL'S STATIC WATER LEVEL **60.7** ft. below land surface measured on **6-22-05**
 Pump test data: Well water was ft. after hours pumping gpm
 Est. Yield gpm: Well water was ft. after hours pumping gpm
 Bore Hole Diameter . . . **11** .in. to **70** .ft., andin. toft.
 WELL WATER TO BE USED AS:
 1 Domestic 3 Feedlot 6 Oil field water supply 9 Dewatering 12 **REMEDIAL**
 2 Irrigation 4 Industrial 7 Lawn and garden only 10 Monitoring well
 Was a chemical/bacteriological sample submitted to Department? Yes No ; If yes, mo/day/yr sample was submitted
 Water Well Disinfected? Yes No

5 TYPE OF BLANK CASING USED: 5 Wrought iron 8 Concrete tile CASING JOINTS: Glued Clamped

1 Steel 3 RMP (SR) 6 Asbestos-Cement 9 Other (specify below) Welded
 PVC 4 ABS 7 Fiberglass Threaded
 Blank casing diameterin. toft., Diain. toft., Diain. toft.
 Casing height above land surface **36** .in., weight **3.535** lbs./ft. Wall thickness or gauge No. **280**

TYPE OF SCREEN OR PERFORATION MATERIAL: 7 PVC 10 Asbestos-cement
 1 Steel 3 Stainless steel 5 Fiberglass 8 RMP (SR) 11 Other (specify)
 2 Brass 4 Galvanized steel 6 Concrete tile 9 ABS 12 None used (open hole)

SCREEN OR PERFORATION OPENINGS ARE:
 1 Continuous slot 3 Mill slot 5 Gauzed wrapped 8 Saw cut 11 None (open hole)
 2 Louvered shutter 4 Key punched 6 Wire wrapped 9 Drilled holes
 7 Torch cut 10 Other (specify)

SCREEN-PERFORATED INTERVALS: Fromft. toft., Fromft. toft.
 GRAVEL PACK INTERVALS: Fromft. toft., Fromft. toft.

6 GROUT MATERIAL: 1 Neat cement 2 Cement grout 3 Bentonite 4 Other

Grout intervals: Fromft. toft., Fromft. toft., Fromft. toft.
 What is the nearest source of possible contamination:
 1 Septic tank 4 Lateral lines 7 Pit privy 10 Livestock pens 14 Abandoned water well
 2 Sewer lines 5 Cess pool 8 Sewage lagoon 11 Fuel storage 15 Oil well/Gas well
 3 Watertight sewer lines 6 Seepage pit 9 Feedyard 12 Fertilizer storage 16 Other (specify below) **UNKNOWN**
 Direction from well? **UNKNOWN** How many feet? **UNKNOWN**

FROM	TO	LITHOLOGIC LOG	FROM	TO	PLUGGING INTERVALS
0	2	ORGANIC CLAY			
2	66	CLAYEY SAND & SILT			
66	70	SILT - WEATHERED SHALE			

7 CONTRACTOR'S OR LANDOWNER'S CERTIFICATION: This water well was (1) constructed, (2) reconstructed, or (3) plugged under my jurisdiction and was completed on (mo/day/year) **6-17-05** and this record is true to the best of my knowledge and belief. Kansas Water Well Contractor's License No. **658** This Water Well Record was completed on (mo/day/year) **8-1-05** under the business name of **BOART LONGYEAR** by (signature) *[Signature]*

OFFICE USE ONLY
T
R
E
W
S
E
C.
1/4
1/4
1/4