


1 LOCATION OF WATER WELL: County: Phillips Fraction: NW 1/4 NE 1/4 SE 1/4 Section Number: 22 Township Number: T 3 S Range Number: R 18 EW

Distance and direction from nearest town or city street address of well if located within city? Highway 183 North

2 WATER WELL OWNER: Coffey Resources Terminal, LLC RR#, St. Address, Box #: Highway 183 North City, State, ZIP Code: Phillipsburg, KS 67661 Board of Agriculture, Division of Water Resources Application Number:

3 LOCATE WELL'S LOCATION WITH AN "X" IN SECTION BOX:

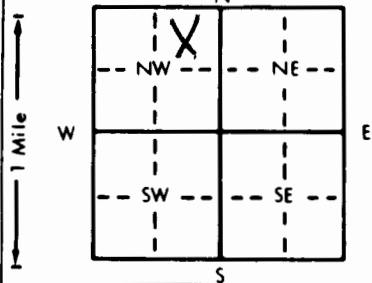

4 DEPTH OF COMPLETED WELL: 61.5 ft. ELEVATION:

Depth(s) Groundwater Encountered: 1. ft. 2. ft. 3. ft. WELL'S STATIC WATER LEVEL: 24.5 ft. below land surface measured on mo/day/yr: 6-21-05 Pump test data: Well water was ... Est. Yield ... Bore Hole Diameter: 11 in. to 65 ft., and ... WELL WATER TO BE USED AS: 5 Public water supply, 8 Air conditioning, 11 Injection well, 12 Other (Specify below) Remedial

5 TYPE OF BLANK CASING USED: 1 Steel, 3 RMP (SR), 5 Wrought iron, 8 Concrete tile, CASING JOINTS: Glued, Clamped

Blank casing diameter: 6 in. to 11.5 ft., Dia. 36 in. weight 3.535 lbs./ft. Wall thickness or gauge No. 280

TYPE OF SCREEN OR PERFORATION MATERIAL: 1 Steel, 3 Stainless steel, 5 Fiberglass, 8 RMP (SR), 10 Asbestos-cement

SCREEN OR PERFORATION OPENINGS ARE: 1 Continuous slot, 2 Mill slot, 5 Gauzed wrapped, 8 Saw cut, 11 None (open hole)

SCREEN-PERFORATED INTERVALS: From 11.5 ft. to 61.5 ft. GRAVEL PACK INTERVALS: From 9.5 ft. to 61.5 ft.

6 GROUT MATERIAL: 1 Neat cement, 2 Cement grout, 3 Bentonite, 4 Other Grout intervals: From 7 ft. to 9.5 ft., From 0 ft. to 7 ft.

What is the nearest source of possible contamination: 1 Septic tank, 4 Lateral lines, 7 Pit privy, 10 Livestock pens, 14 Abandoned water well

Direction from well? unknown How many feet? unknown

Table with columns: FROM, TO, LITHOLOGIC LOG, FROM, TO, PLUGGING INTERVALS. Entry: 0 to 61, Silty, Sandy, Clay; 61 to 65, Weathered Shale.

7 CONTRACTOR'S OR LANDOWNER'S CERTIFICATION: This water well was (1) constructed, (2) reconstructed, or (3) plugged under my jurisdiction and was completed on (mo/day/year) 6-10-05 and this record is true to the best of my knowledge and belief. Kansas Water Well Contractor's License No. 658 This Water Well Record was completed on (mo/day/yr) 8-1-05 under the business name of Beart Longyear by (signature)