


1 LOCATION OF WATER WELL: County: Phillips Fraction SW 1/4 NE 1/4 SE 1/4 Section Number 22 Township Number T 3 S Range Number R 18 EW

Distance and direction from nearest town or city street address of well if located within city? Highway 183 North

2 WATER WELL OWNER: Coffey Resources Terminal, LLC RR#, St. Address, Box #: Highway 183 North City, State, ZIP Code: Phillipsburg, KS 67661 Board of Agriculture, Division of Water Resources Application Number:

3 LOCATE WELL'S LOCATION WITH AN "X" IN SECTION BOX: 4 DEPTH OF COMPLETED WELL: 55 ft. ELEVATION:

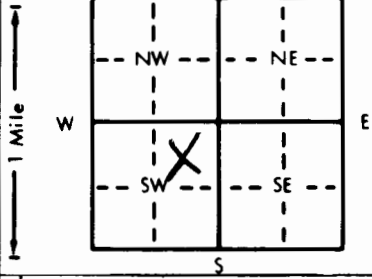

Depth(s) Groundwater Encountered 1. ft. 2. ft. 3. ft. WELL'S STATIC WATER LEVEL 28.8 ft. below land surface measured on mo/day/yr Pump test data: Well water was ft. after hours pumping gpm Est. Yield gpm Well water was ft. after hours pumping gpm Bore Hole Diameter 11 in. to 62 ft. and in. to ft. WELL WATER TO BE USED AS: 5 Public water supply 8 Air conditioning 11 Injection well 1 Domestic 3 Feedlot 6 Oil field water supply 9 Dewatering 12 Other (Specify below) Remedial 2 Irrigation 4 Industrial 7 Lawn and garden only 10 Monitoring well Was a chemical/bacteriological sample submitted to Department? Yes No If yes, mo/day/yr sample was submitted Water Well Disinfected? Yes No

5 TYPE OF BLANK CASING USED: 1 Steel 3 RMP (SR) 5 Wrought iron 8 Concrete tile CASING JOINTS: Glued Clamped 2 PVC 4 ABS 6 Asbestos-Cement 9 Other (specify below) Welded 7 Fiberglass Threaded YES Blank casing diameter 6 in. to 15 ft. Dia in. to ft. Dia in. to ft. Casing height above land surface 36 in. weight 3.535 lbs./ft. Wall thickness or gauge No. 280

TYPE OF SCREEN OR PERFORATION MATERIAL: 1 Steel 3 Stainless steel 5 Fiberglass 8 RMP (SR) 10 Asbestos-cement 2 Brass 4 Galvanized steel 6 Concrete tile 9 ABS 11 Other (specify) 12 None used (open hole) PVC

SCREEN OR PERFORATION OPENINGS ARE: 1 Continuous slot 2 Mill slot 3 Mill slot 5 Gauzed wrapped 8 Saw cut 11 None (open hole) 2 Louvered shutter 4 Key punched 6 Wire wrapped 9 Drilled holes 10 Other (specify)

SCREEN-PERFORATED INTERVALS: From 15 ft. to 55 ft. From ft. to ft. From ft. to ft. From ft. to ft. GRAVEL PACK INTERVALS: From 13 ft. to 55 ft. From ft. to ft. From ft. to ft. From ft. to ft.

6 GROUT MATERIAL: 1 Neat cement 2 Cement grout 3 Bentonite 4 Other Grout intervals: From 11 ft. to 13 ft. From 0 ft. to 11 ft. From ft. to ft. From ft. to ft.

What is the nearest source of possible contamination: 1 Septic tank 4 Lateral lines 7 Pit privy 10 Livestock pens 14 Abandoned water well 2 Sewer lines 5 Cess pool 8 Sewage lagoon 11 Fuel storage 15 Oil well/Gas well 3 Watertight sewer lines 6 Seepage pit 9 Feedyard 12 Fertilizer storage 16 Other (specify below) unknown 13 Insecticide storage

Direction from well? unknown How many feet? unknown

Table with 4 columns: FROM, TO, LITHOLOGIC LOG, PLUGGING INTERVALS. Row 1: FROM 0 TO 59, LITHOLOGIC LOG Silty sandy clay, PLUGGING INTERVALS. Row 2: FROM 59 TO 62, LITHOLOGIC LOG shale, PLUGGING INTERVALS. Bottom of table: B-102

7 CONTRACTOR'S OR LANDOWNER'S CERTIFICATION: This water well was (1) constructed, (2) reconstructed, or (3) plugged under my jurisdiction and was completed on (mo/day/year) 6-12-05 and this record is true to the best of my knowledge and belief, Kansas Water Well Contractor's License No. 658 This Water Well Record was completed on (mo/day/yr) 8-1-05 under the business name of Scott Longyear by signature