


1 LOCATION OF WATER WELL: Fraction SE 1/4 NW 1/4 NE 1/4 Section Number 25 Township Number T 3 S Range Number R 18 E NW
 County: Phillips

Distance and direction from nearest town or city street address of well if located within city?
1/2 mile north on 100 Rd & 1/4 mile east from Phillipsburg Ks. (New Ethanol Plant)

2 WATER WELL OWNER: TCM, INC
 RR#, St. Address, Box # : 310 N 1st St Board of Agriculture, Division of Water Resources
 City, State, ZIP Code : Colwich, KS 67030-0397 Application Number:

3 LOCATE WELL'S LOCATION WITH AN "X" IN SECTION BOX: 4 DEPTH OF COMPLETED WELL 104 ft. ELEVATION:

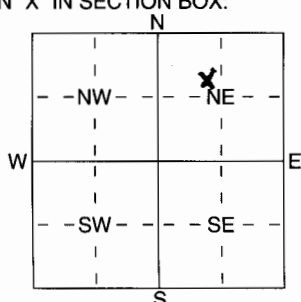

Depth(s) Groundwater Encountered 10 56 ft. 2 ft. 3 ft.
 WELL'S STATIC WATER LEVEL 62 ft. below land surface measured on mo/day/yr 10-15-05
 Pump test data: Well water was 60 ft. after 1 hours pumping 10 gpm
 Est. Yield 10 gpm: Well water was ft. after hours pumping gpm
 WELL WATER TO BE USED AS:
 1 Domestic 3 Feedlot 6 Oil field water supply 9 Dewatering 12 Other (Specify below)
 2 Irrigation 4 Industrial 7 Domestic (lawn & garden) 10 Monitoring well

Was a chemical/bacteriological sample submitted to Department? Yes No ; If yes, mo/day/yr sample was submitted
 Water Well Disinfected? Yes No

5 TYPE OF BLANK CASING USED:
 1 Steel 3 RMP (SR) 5 Wrought iron 8 Concrete tile CASING JOINTS: Glued Clamped
 2 PVC 4 ABS 6 Asbestos-Cement 9 Other (specify below) Welded
 7 Fiberglass Threaded

Blank casing diameter 5 in. to 84 ft., Dia in. to ft., Dia in. to ft.
 Casing height above land surface 24 in., weight 160 lbs./ft. Wall thickness or gauge No.

TYPE OF SCREEN OR PERFORATION MATERIAL:
 1 Steel 3 Stainless Steel 5 Fiberglass 7 PVC 10 Asbestos-Cement
 2 Brass 4 Galvanized Steel 6 Concrete tile 8 RMP (SR) 11 Other (Specify)
 12 None used (open hole)

SCREEN OR PERFORATION OPENINGS ARE:
 1 Continuous slot 3 Mill slot 5 Guazed wrapped 8 Saw cut 11 None (open hole)
 2 Louvered shutter 4 Key punched 6 Wire wrapped 9 Drilled holes
 7 Torch cut 10 Other (specify) ft.

SCREEN-PERFORATED INTERVALS: From 104 ft. to 84 ft., From ft. to ft.
 From ft. to ft., From ft. to ft.
 GRAVEL PACK INTERVALS: From 104 ft. to 20 ft., From ft. to ft.
 From ft. to ft., From ft. to ft.

6 GROUT MATERIAL: 1 Neat cement 2 Cement grout 3 Bentonite 4 Other
 Grout Intervals: From 20 ft. to 0 ft., From ft. to ft., From ft. to ft.

What is the nearest source of possible contamination:
 1 Septic tank 4 Lateral lines 7 Pit privy 10 Livestock pens 14 Abandoned water well
 2 Sewer lines 5 Cess pool 8 Sewage lagoon 11 Fuel storage 15 Oil well/Gas well
 3 Watertight sewer lines 6 Seepage pit 9 Feedyard 12 Fertilizer storage 16 Other (specify below)
 13 Insecticide storage None

Direction from well? How many feet?

FROM	TO	LITHOLOGIC LOG	FROM	TO	PLUGGING INTERVALS
<u>0</u>	<u>30</u>	<u>Dark Brown Clay</u>			
<u>31</u>	<u>45</u>	<u>Light Brown Clay</u>			
<u>46</u>	<u>56</u>	<u>med sand, gravel</u>			
<u>57</u>	<u>102</u>	<u>sand, gravel, clay, rock</u>			
<u>102</u>	<u>104</u>	<u>Shale</u>			

7 CONTRACTOR'S OR LANDOWNER'S CERTIFICATION: This water well was (1) constructed, (2) reconstructed, or (3) plugged under my jurisdiction and was completed on (mo/day/year) 10-15-05 and this record is true to the best of my knowledge and belief, Kansas Water Well Contractor's Licence No 738 This Water Well Record was completed on (mo/day/yr) 10-15-05 under the business name Ledingee Well Service by (signature) [Signature]