

#26


WATER WELL RECORD Form WWC-5 KSA 82a-1212

1 LOCATION OF WATER WELL: Fraction NE 1/4 SW 1/4 SE 1/4 Section Number 22 Township Number T 3 S Range Number R 18 EW  
 County: PHILLIPS

Distance and direction from nearest town or city street address of well if located within city?  
1/2 mile NW of PHILLIPSBURG

2 WATER WELL OWNER: FARMLAND INDUSTRIES INC.  
 RR#, St. Address, Box #: RT. 2 Board of Agriculture, Division of Water Resources  
 City, State, ZIP Code: PHILLIPSBURG KANSAS Application Number:

3 LOCATE WELL'S LOCATION WITH AN "X" IN SECTION BOX:

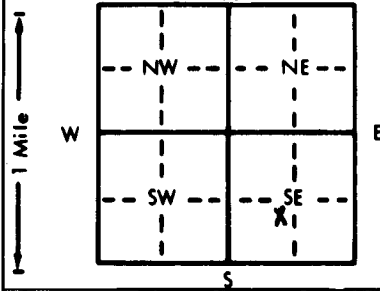

4 DEPTH OF COMPLETED WELL: 42 ft. ELEVATION: 949.23 6.4  
 Depth(s) Groundwater Encountered 34.50 ft. 2. 34.50 ft. 3. 34.50 ft.  
 WELL'S STATIC WATER LEVEL 34.50 ft. below land surface measured on mo/day/yr 6/4/87  
 Pump test data: Well water was N/A ft. after N/A hours pumping N/A gpm  
 Est. Yield 2 gpm; Well water was N/A ft. after N/A hours pumping N/A gpm  
 Bore Hole Diameter 4 3/8 in. to 42 ft., and 42 in. to 42 ft.  
 WELL WATER TO BE USED AS:  
 5 Public water supply 8 Air conditioning 11 Injection well  
 1 Domestic 3 Feedlot 6 Oil field water supply 9 Dewatering 12 Other (Specify below)  
 2 Irrigation 4 Industrial 7 Lawn and garden only 10 Observation well  
 Was a chemical/bacteriological sample submitted to Department? Yes.....No.....; If yes, mo/day/yr sample was submitted

5 TYPE OF BLANK CASING USED:  
 1 Steel 3 RMP (SR) 5 Wrought iron 8 Concrete tile CASING JOINTS: Glued Clamped  
2 PVC 4 ABS 6 Asbestos-Cement 9 Other (specify below) Welded  
 7 Fiberglass Threaded  
 Blank casing diameter 2 in. to 2 ft., Dia. 2 in. to 2 ft., Dia. 2 in. to 2 ft.  
 Casing height above land surface 3.42 in., weight 3.42 lbs./ft. Wall thickness or gauge No. SCH. 40  
 TYPE OF SCREEN OR PERFORATION MATERIAL:  
 1 Steel 3 Stainless steel 5 Fiberglass 8 RMP (SR) 10 Asbestos-cement  
 2 Brass 4 Galvanized steel 6 Concrete tile 9 ABS 11 Other (specify)  
 12 None used (open hole)  
 SCREEN OR PERFORATION OPENINGS ARE:  
 1 Continuous slot 3 Mill slot 5 Gauzed wrapped 8 Saw cut 11 None (open hole)  
 2 Louvered shutter 4 Key punched 6 Wire wrapped 9 Drilled holes  
 7 Torch cut 10 Other (specify)  
 SCREEN-PERFORATED INTERVALS: From 22 ft. to 42 ft., From 22 ft. to 42 ft.  
 GRAVEL PACK INTERVALS: From 19 ft. to 42 ft., From 19 ft. to 42 ft.

6 GROUT MATERIAL: 1 Neat cement 2 Cement grout 3 Bentonite 4 Other  
 Grout intervals: From 0 ft. to 17 1/2 ft., From 17.5 ft. to 19 ft., From 19 ft. to 19 ft.  
 What is the nearest source of possible contamination:  
 1 Septic tank 4 Lateral lines 7 Pit privy 10 Livestock pens 14 Abandoned water well  
 2 Sewer lines 5 Cess pool 8 Sewage lagoon 11 Fuel storage 15 Oil well/Gas well  
 3 Watertight sewer lines 6 Seepage pit 9 Feedyard 12 Fertilizer storage 16 Other (specify below)  
 13 Insecticide storage

Direction from well? How many feet?

FROM	TO	LITHOLOGIC LOG	FROM	TO	LITHOLOGIC LOG
0	27	CLAY SILT			
27	29	SILTY SAND			
29	32	SAND			
32	35	SILTY-CLAY			
35	42	CLAY			

7 CONTRACTOR'S OR LANDOWNER'S CERTIFICATION: This water well was (1) constructed, (2) reconstructed, or (3) plugged under my jurisdiction and was completed on (mo/day/year) 6/3/87 and this record is true to the best of my knowledge and belief. Kansas Water Well Contractor's License No. 145 This Water Well Record was completed on (mo/day/yr) 6-22-87 under the business name of Hank Drilling & Supply Co, Inc. by (signature) Bruce J. Richmond

INSTRUCTIONS: Use typewriter or ball point pen. PLEASE PRESS FIRMLY and PRINT clearly. Please fill in blanks, underline or circle the correct answers. Send top three copies to Kansas Department of Health and Environment, Office of Oil Field and Environmental Geology, Regulation and Permitting Section, Topeka, Kansas 66620-7500, Telephone: 913-862-9360. Send one to WATER WELL OWNER and retain one for your records.