


1 LOCATION OF WATER WELL: Fraction NE 1/4 SW 1/4 SE 1/4 Section Number 22 Township Number T 3 S Range Number R 18 E/W

Distance and direction from nearest town or city street address of well if located within city? 1/2 mile NW of PHILLIPSBURG

2 WATER WELL OWNER: FARMHAND INDUSTRIES INC. RR#, St. Address, Box #: RT 2 PHILLIPSBURG KANSAS Board of Agriculture, Division of Water Resources Application Number:

3 LOCATE WELL'S LOCATION WITH AN "X" IN SECTION BOX: 4 DEPTH OF COMPLETED WELL: 37 1/2 ft. ELEVATION: 1942.51 GL

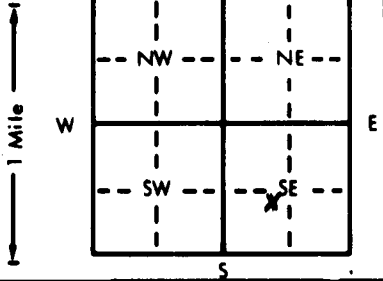

Depth(s) Groundwater Encountered 1. 29.23 ft. 2. ft. 3. ft. WELL'S STATIC WATER LEVEL 29.23 ft. below land surface measured on mo/day/yr 6/4/87 Pump test data: Well water was N/A ft. after hours pumping gpm Est. Yield 40 gpm Well water was N/A ft. after hours pumping gpm Bore Hole Diameter 10 9/8 in. to 38 ft. and 4 5/8 in. to 50 ft. WELL WATER TO BE USED AS: 5 Public water supply 8 Air conditioning 11 Injection well 1 Domestic 3 Feedlot 6 Oil field water supply 9 Dewatering 12 Other (Specify below) H.C. Recovery 2 Irrigation 4 Industrial 7 Lawn and garden only 10 Observation well Was a chemical/bacteriological sample submitted to Department? Yes No If yes, mo/day/yr sample was submitted Water Well Disinfected Yes No

5 TYPE OF BLANK CASING USED: 1 Steel 2 PVC 3 RMP (SR) 4 ABS 5 Wrought iron 6 Asbestos-Cement 7 Fiberglass 8 Concrete tile 9 Other (specify below) CASING JOINTS Glued Clamped Welded Threaded Blank casing diameter 6 in. to ft. Dia in. to ft. Dia in. to ft. Casing height above land surface 155 in. weight lbs./ft. Wall thickness or gauge No. SCH. 40

TYPE OF SCREEN OR PERFORATION MATERIAL: 1 Steel 2 Brass 3 Stainless steel 4 Galvanized steel 5 Fiberglass 6 Concrete tile 7 PVC 8 RMP (SR) 9 ABS 10 Asbestos-cement 11 Other (specify) 12 None used (open hole)

SCREEN OR PERFORATION OPENINGS ARE: 1 Continuous slot 2 Louvered shutter 3 Mill slot 4 Key punched 5 Gauzed wrapped 6 Wire wrapped 7 Torch cut 8 Saw cut 9 Drilled holes 11 None (open hole) 10 Other (specify)

SCREEN-PERFORATED INTERVALS: From 22.5 ft. to 37.5 ft. GRAVEL PACK INTERVALS: From 19.5 ft. to 37.5 ft.

6 GROUT MATERIAL: 1 Neat cement 2 Cement grout 3 Bentonite 4 Other Grout Intervals: From 0 ft. to 19 ft. From 19 ft. to 19.5 ft.

What is the nearest source of possible contamination: 1 Septic tank 2 Sewer lines 3 Watertight sewer lines 4 Lateral lines 5 Cess pool 6 Seepage pit 7 Pit privy 8 Sewage lagoon 9 Feedyard 10 Livestock pens 11 Fuel storage 12 Fertilizer storage 13 Insecticide storage 14 Abandoned water well 15 Oil well/Gas well 16 Other (specify below)

Direction from well? Immediate Area How many feet?

Table with columns: FROM, TO, LITHOLOGIC LOG. Data rows: 0-30' clayey silt, 30-36' sand, 36-37 1/2' gravel, 37 1/2-50' clayey silt.

7 CONTRACTOR'S OR LANDOWNER'S CERTIFICATION: This water well was (1) constructed, (2) reconstructed, or (3) plugged under my jurisdiction and was completed on (mo/day/year) 5-18-87 and this record is true to the best of my knowledge and belief. Kansas Water Well Contractor's License No. 145 This Water Well Record was completed on (mo/day/yr) 6-22-87 under the business name of Henkle Drilling & Supply Co., Inc. by (signature) Bruce J. Richmond

INSTRUCTIONS: Use typewriter or ball point pen. PLEASE PRESS FIRMLY and PRINT clearly. Please fill in blanks, underline or circle the correct answers. Send top three copies to Kansas Department of Health and Environment, Office of Oil Field and Environmental Geology, Regulation and Permitting Section, Topeka, Kansas 66620-7500, Telephone: 913-862-9360. Send one to WATER WELL OWNER and retain one for your records.