


1] LOCATION OF WATER WELL:	Fraction	Section Number	Township Number	Range Number
County: Phillips	SE 1/4 SE 1/4 NE 1/4	22	T 3 S	R 18 E <u>W</u>

Distance and direction from nearest town or city street address of well if located within city?
1/2 Mile N of Phillipsburg MW 1

2] WATER WELL OWNER: **Farmland Industries, Inc.**
 RR#, St. Address, Box # : **P.O. Box 608** Board of Agriculture, Division of Water Resources
 City, State, ZIP Code : **Phillipsburg, Ks. 67661** Application Number:

3] LOCATE WELL'S LOCATION WITH AN "X" IN SECTION BOX: 4] DEPTH OF COMPLETED WELL... **48** ft. ELEVATION: **1959.16**

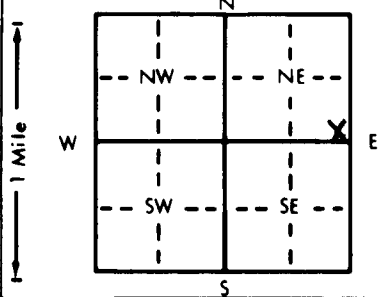

Depth(s) Groundwater Encountered **1.38** ft. 2. ft. 3. ft.
 WELL'S STATIC WATER LEVEL **3.8** ft. below land surface measured on mo/day/yr **2-13-91**
 Pump test data: Well water was ... ft. after ... hours pumping ... gpm
 Est. Yield ... gpm: Well water was ... ft. after ... hours pumping ... gpm
 Bore Hole Diameter **7.5/8** in. to **4.8** ft., and ... in. to ... ft.
 WELL WATER TO BE USED AS:
 5 Public water supply 8 Air conditioning 11 Injection well
 1 Domestic 3 Feedlot 6 Oil field water supply 9 Dewatering 12 Other (Specify below)
 2 Irrigation 4 Industrial 7 Lawn and garden only **10 Monitoring well**
 Was a chemical/bacteriological sample submitted to Department? Yes.....No.....; If yes, mo/day/yr sample was sub-
 mitted Water Well Disinfected? Yes No

5] TYPE OF BLANK CASING USED:
 1 Steel 3 RMP (SR) 5 Wrought iron 8 Concrete tile CASING JOINTS: Glued Clamped
2 PVC 4 ABS 6 Asbestos-Cement 9 Other (specify below) Welded
 7 Fiberglass Threaded

Blank casing diameter **2** in. to **3.3** ft., Dia. in. to ... ft., Dia. in. to ... ft.
 Casing height above land surface **3.1** in., weight ... lbs./ft. Wall thickness or gauge No. **Sch. 40**

TYPE OF SCREEN OR PERFORATION MATERIAL:
 1 Steel **3 Stainless steel** 5 Fiberglass 7 PVC 10 Asbestos-cement
 2 Brass 4 Galvanized steel 6 Concrete tile 8 RMP (SR) 11 Other (specify)
 SCREEN OR PERFORATION OPENINGS ARE:
 1 Continuous slot 3 Mill slot 5 Gauzed wrapped 8 Saw cut 11 None (open hole)
 2 Louvered shutter 4 Key punched **6 Wire wrapped** 9 Drilled holes

SCREEN-PERFORATED INTERVALS: From **4.8** ft. to **3.3** ft., From ... ft. to ... ft.
 GRAVEL PACK INTERVALS: From **4.8** ft. to **3.1** ft., From ... ft. to ... ft.

6] GROUT MATERIAL: **1 Neat cement** 2 Cement grout **3 Bentonite** 4 Other
 Grout Intervals: From **3.1** ft. to **2.9** (Bent) From **2.9** ft. to **0** (cement) From ... ft. to ... ft.
 What is the nearest source of possible contamination:
 1 Septic tank 4 Lateral lines 7 Pit privy 10 Livestock pens 14 Abandoned water well
 2 Sewer lines 5 Cess pool 8 Sewage lagoon 11 Fuel storage 15 Oil well/Gas well
 3 Watertight sewer lines 6 Seepage pit 9 Feedyard 12 Fertilizer storage **16 Other (specify below)**
Industrial facility

Direction from well? How many feet?

FROM	TO	LITHOLOGIC LOG	FROM	TO	PLUGGING INTERVALS
0	5	Olive gray silt loam			
5	10	Very pale brown silty sand			
10	20	Very pale brown sandy silt			
20	35	Brown sandy silty clay			
35	48	Yellow clayey sandy silt			

7] CONTRACTOR'S OR LANDOWNER'S CERTIFICATION: This water well was **(1) constructed** (2) reconstructed, or (3) plugged under my jurisdiction and was completed on (mo/day/year) **2-11-91** and this record is true to the best of my knowledge and belief. Kansas Water Well Contractor's License No. **5.27** This Water Well Record was completed on (mo/day/yr) **3-15-91** under the business name of **GeoCore Services, Inc.** by (signature) *Dale A. Roll*