


1 LOCATION OF WATER WELL: Fraction SW 1/4 SW 1/4 NW 1/4 Section Number 23 Township Number T 3 S Range Number R 18 E/W  
 County: Phillips

Distance and direction from nearest town or city street address of well if located within city?  
3 mile north of Phillipsburg Kansas

2 WATER WELL OWNER: Charence Ruple  
 RR#, St. Address, Box #: RR 1 Phillipsburg Kansas 67661 Board of Agriculture, Division of Water Resources  
 City, State, ZIP Code: Phillipsburg Kansas 67661 Application Number:

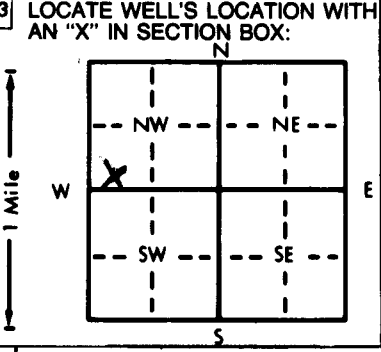

4 DEPTH OF COMPLETED WELL: 93 ft. ELEVATION: ..... ft.  
 Depth(s) Groundwater Encountered 1. .... ft. 2. .... ft. 3. .... ft.  
 WELL'S STATIC WATER LEVEL 40 ft. below land surface measured on mo/day/yr 6-12-89  
 Pump test data: Well water was ..... ft. after ..... hours pumping ..... gpm  
 Est. Yield 3.0 gpm: Well water was ..... ft. after ..... hours pumping ..... gpm  
 Bore Hole Diameter: 5 in. to 93 ft., and ..... in. to ..... ft.  
 WELL WATER TO BE USED AS:  
 1 Domestic     3 Feedlot     6 Oil field water supply     9 Dewatering     12 Other (Specify below)  
 2 Irrigation     4 Industrial     7 Lawn and garden only     10 Observation well  
 Was a chemical/bacteriological sample submitted to Department? Yes..... No.....; If yes, mo/day/yr sample was submitted  
 Water Well Disinfected? Yes    No

5 TYPE OF BLANK CASING USED:  
 1 Steel     3 RMP (SR)     5 Wrought iron     8 Concrete tile    CASING JOINTS: Glued ..... Clamped .....  
 2 PVC     4 ABS     6 Asbestos-Cement     9 Other (specify below)    Welded .....  
 Blank casing diameter 5 in. to 68 ft., Dia ..... in. to ..... ft., Dia ..... in. to ..... ft.  
 Casing height above land surface 12 in., weight 160 lbs./ft. Wall thickness or gauge No. ....  
 TYPE OF SCREEN OR PERFORATION MATERIAL:  
 1 Steel     3 Stainless steel     5 Fiberglass     8 RMP (SR)     11 Other (specify) .....  
 2 Brass     4 Galvanized steel     6 Concrete tile     9 ABS     12 None used (open hole)  
 SCREEN OR PERFORATION OPENINGS ARE:  
 1 Continuous slot     3 Mill slot     5 Gauzed wrapped     8 Saw cut     11 None (open hole)  
 2 Louvered shutter     4 Key punched     6 Wire wrapped     9 Drilled holes  
 7 Torch cut     10 Other (specify) .....  
 SCREEN-PERFORATED INTERVALS: From 73 ft. to 93 ft., From ..... ft. to ..... ft.  
 From ..... ft. to ..... ft., From ..... ft. to ..... ft.  
 GRAVEL PACK INTERVALS: From 2.5 ft. to 93 ft., From ..... ft. to ..... ft.  
 From ..... ft. to ..... ft., From ..... ft. to ..... ft.

6 GROUT MATERIAL:  1 Neat cement     2 Cement grout     3 Bentonite     4 Other .....  
 Grout Intervals: From 5 ft. to 2.5 ft., From ..... ft. to ..... ft., From ..... ft. to ..... ft.  
 What is the nearest source of possible contamination:  
 1 Septic tank     4 Lateral lines     7 Pit privy     10 Livestock pens     14 Abandoned water well  
 2 Sewer lines     5 Cess pool     8 Sewage lagoon     11 Fuel storage     15 Oil well/Gas well  
 3 Watertight sewer lines     6 Seepage pit     9 Feedyard     12 Fertilizer storage     16 Other (specify below)  
 Direction from well? West to south west How many feet? 55

FROM	TO	LITHOLOGIC LOG	FROM	TO	LITHOLOGIC LOG
0	30	Clay			
30	40	Sand & Rock layers			
40	62	Sand & clay layers			
62	92	Dark sand & brown clay layers			
92	93	Shale			

7 CONTRACTOR'S OR LANDOWNER'S CERTIFICATION: This water well was (1) constructed, (2) reconstructed, or (3) plugged under my jurisdiction and was completed on (mo/day/year) 6-12-89 and this record is true to the best of my knowledge and belief. Kansas Water Well Contractor's License No. 388 This Water Well Record was completed on (mo/day/yr) 6-26-89 under the business name of OTT Enterprises by (signature) Paul Ott