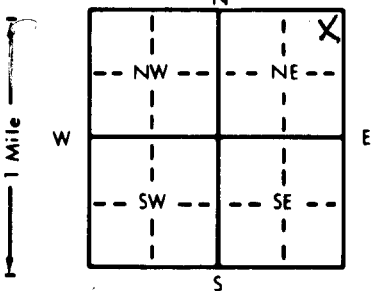


WATER WELL RECORD Form WWC-5 KSA 82a-1212

1 LOCATION OF WATER WELL:		Fraction		Section Number		Township Number		Range Number	
County: Phillips		NE 1/4 NE 1/4 NE 1/4		27		T 3 S		R 18 EW	
Distance and direction from nearest town or city street address of well if located within city? Intersection of Cable Road & Hwy. 183. Phillipsburg, KS PCA-4									
2 WATER WELL OWNER: Phillipsburg Coop Assoc.									
RR#, St. Address, Box # : P.O. Box 624									
City, State, ZIP Code : Phillipsburg, Ks.									
Board of Agriculture, Division of Water Resources Application Number:									
3 LOCATE WELL'S LOCATION WITH AN "X" IN SECTION BOX:			4 DEPTH OF COMPLETED WELL: 50 ft. ELEVATION: 1948.26 (PVC)						
			Depth(s) Groundwater Encountered 1. 40 ft. 2. ft. 3. ft.						
			WELL'S STATIC WATER LEVEL ft. below land surface measured on mo/day/yr						
			Pump test data: Well water was ft. after hours pumping gpm						
			Est. Yield gpm: Well water was ft. after hours pumping gpm						
			Bore Hole Diameter: 7 5/8 in. to 50 ft., and in. to ft.						
WELL WATER TO BE USED AS:									
1 Domestic 3 Feedlot 6 Oil field water supply 8 Air conditioning 11 Injection well									
2 Irrigation 4 Industrial 7 Lawn and garden only 10 Monitoring well PCA-4 12 Other (Specify below)									
Was a chemical/bacteriological sample submitted to Department? Yes No XX ; If yes, mo/day/yr sample was submitted									
Water Well Disinfected? Yes No XX									
5 TYPE OF BLANK CASING USED:									
1 Steel 3 RMP (SR) 5 Wrought iron 8 Concrete tile CASING JOINTS: Glued Clamped									
2 PVC 4 ABS 6 Asbestos-Cement 9 Other (specify below) Welded									
7 Fiberglass Threaded XX									
Blank casing diameter 2 in. to 30 ft., Dia in. to ft., Dia in. to ft.									
Casing height above land surface 0 in., weight lbs./ft. Wall thickness or gauge No. Sch. 40									
TYPE OF SCREEN OR PERFORATION MATERIAL:									
1 Steel 3 Stainless steel 5 Fiberglass 7 PVC 10 Asbestos-cement									
2 Brass 4 Galvanized steel 6 Concrete tile 8 RMP (SR) 11 Other (specify)									
9 ABS 12 None used (open hole)									
SCREEN OR PERFORATION OPENINGS ARE:									
1 Continuous slot 3 Mill slot 5 Gauzed wrapped 8 Saw cut 11 None (open hole)									
2 Louvered shutter 4 Key punched 6 Wire wrapped 9 Drilled holes									
7 Torch cut 10 Other (specify)									
SCREEN-PERFORATED INTERVALS: From 50 ft. to 30 ft., From ft. to ft.									
From ft. to ft., From ft. to ft.									
GRAVEL PACK INTERVALS: From 50 ft. to 28 ft., From ft. to ft.									
From ft. to ft., From ft. to ft.									
6 GROUT MATERIAL: 1 Neat cement 2 Cement grout 3 bent 3 Bentonite 4 Other									
Grout Intervals: From 28 ft. to 24.6 (3) ft., From 24.6 (2) ft. to 0 ft., From ft. to ft.									
What is the nearest source of possible contamination:									
1 Septic tank 4 Lateral lines 7 Pit privy 10 Livestock pens 14 Abandoned water well									
2 Sewer lines 5 Cess pool 8 Sewage lagoon 11 Fuel storage 15 Oil well/Gas well									
3 Watertight sewer lines 6 Seepage pit 9 Feedyard 12 Fertilizer storage 16 Other (specify below)									
13 Insecticide storage									
Direction from well? Southeast How many feet? 100									
FROM TO LITHOLOGIC LOG			FROM TO PLUGGING INTERVALS						
0 4.5 Brown silty clay									
4.5 9.5 Brown silt									
9.5 14.5 Brown silt									
14.5 19.5 Brown silt									
19.5 24.5 Tan silt									
24.5 29.5 Brown sandy clay silt									
29.5 34.5 Light brownish gray silt									
34.5 39.5 Light gray sand									
39.5 50 Brown clayey sand									
7 CONTRACTOR'S OR LANDOWNER'S CERTIFICATION: This water well was (1) constructed, (2) reconstructed, or (3) plugged under my jurisdiction and was completed on (mo/day/year) 02-27-92 and this record is true to the best of my knowledge and belief. Kansas Water Well Contractor's License No. 527 This Water Well Record was completed on (mo/day/yr) 07-31-92 under the business name of GeoCore Services, Inc. by (signature) Doc Rell									