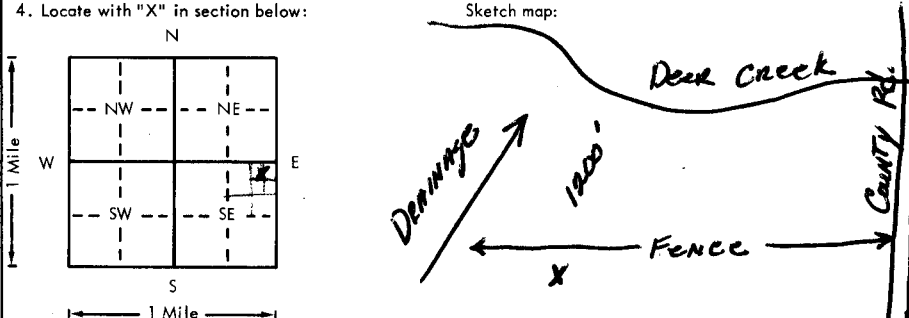


USE TYPEWRITER OR BALL
POINT PEN-PRESS FIRMLY,
PRINT CLEARLY.

WATER WELL RECORD
KSA 82a-1201-1215

Kansas Department of Health and
Environment-Division of Environment
(Water well Contractors)
Topeka, Kansas 66620

1. Location of well:		County Phillips	Fraction NE 1/4 NE 1/4 SE 1/4	Section number 32	Township number T 3	Range number S R 18	W
2. Distance and direction from nearest town or city: 2 mi. west & 1/2 mi. south of Street address of well location if in city: Phillipsburg				3. Owner of well: LaVon Cole R.R. or street: Rt. 4 City, state, zip code: Phillipsburg, Ks. 67661			
4. Locate with "X" in section below: 				6. Bore hole dia. 9 1/2 in. Completion date Well depth 55 ft. 7-15-79			
5. Type and color of material				7. <input checked="" type="checkbox"/> Cable tool <input type="checkbox"/> Rotary <input type="checkbox"/> Driven <input type="checkbox"/> Dug <input type="checkbox"/> Hollow rod <input type="checkbox"/> Jetted <input type="checkbox"/> Bored <input type="checkbox"/> Reverse rotary			
Top Soil				8. Use: <input checked="" type="checkbox"/> Domestic <input type="checkbox"/> Public supply <input type="checkbox"/> Industry <input type="checkbox"/> Irrigation <input type="checkbox"/> Air conditioning <input type="checkbox"/> Stock <input type="checkbox"/> Lawn <input type="checkbox"/> Oil field water <input type="checkbox"/> Other			
Lt. Yellow Clay				9. Casing: Material Plastic Height: Above or below Threaded <input type="checkbox"/> Welded <input type="checkbox"/> Surface 24 in. RMP <input type="checkbox"/> PVC <input checked="" type="checkbox"/> Weight <input type="checkbox"/> lbs./ft. Dia. 6 in. to 55 ft. depth Wall Thickness: inches or Dia. <input type="checkbox"/> in. to <input type="checkbox"/> ft. depth Gauge No. Sch. 200			
Lt. Yellow Clay with sand streaks				10. Screen: Manufacturer's name Western			
Fine dirty sand with shells				Type PVC Dia. 6" Slot/gauze 1/8" Length 10' Set between 45 ft. and 55 ft. Gravel pack? yes Size range of material 4" minus			
Shale				11. Static water level: <input type="checkbox"/> mo./day/yr. 35 ft. below land surface Date 7-15-79			
12. Pumping level below land surfaces: ____ ft. after ____ hrs. pumping ____ g.p.m. ____ ft. after ____ hrs. pumping ____ g.p.m. Estimated maximum yield 20 g.p.m.				13. Water sample submitted: <input type="checkbox"/> mo./day/yr. <input type="checkbox"/> Yes <input checked="" type="checkbox"/> No Date			
14. Well head completion: <input checked="" type="checkbox"/> Pitless adapter ____ inches above grade				15. Well grouted? yes With: <input checked="" type="checkbox"/> Neat cement <input type="checkbox"/> Bentonite <input type="checkbox"/> Concrete Depth: From 8 ft. to 18 ft.			
16. Nearest source of possible contamination: None ft. ____ Direction ____ Type ____ Well disinfected upon completion? <input checked="" type="checkbox"/> Yes <input type="checkbox"/> No				17. Pump: <input checked="" type="checkbox"/> Not installed Manufacturer's name ____ Model number ____ HP ____ Volts ____ Length of drop pipe ____ ft. capacity ____ g.p.m. Type: <input type="checkbox"/> Submersible <input type="checkbox"/> Turbine <input type="checkbox"/> Jet <input type="checkbox"/> Reciprocating <input type="checkbox"/> Centrifugal <input type="checkbox"/> Other			
18. Elevation:				20. Water well contractor's certification: This well was drilled under my jurisdiction and this report is true to the best of my knowledge and belief. Deer Drilling 314 Business name Rt 4 Phillipsburg, Ks. License No. Address William J. Deer 7-17-79 Signed William J. Deer Date 7-17-79 Authorized representative			
19. Remarks: Not in of 1000' 54' 19' TOPO 1902 54 1848							