


1 LOCATION OF WATER WELL: County: **Phillips** Fraction: **NE 1/4 NE 1/4 NE 1/4** Section Number: **35** Township Number: **T 3 S** Range Number: **R 18 EW**

Distance and direction from nearest town or city street address of well if located within city?

2 WATER WELL OWNER: **Gary D. Bills**  
 RR#, St. Address, Box #: **240 Fisher Dr.**  
 City, State, ZIP Code: **Phillipsburg, Kansas 67661**  
 Board of Agriculture, Division of Water Resources  
 Application Number:

3 LOCATE WELL'S LOCATION WITH AN "X" IN SECTION BOX: **12** DEPTH OF COMPLETED WELL: ... ft. ELEVATION: ... ft.

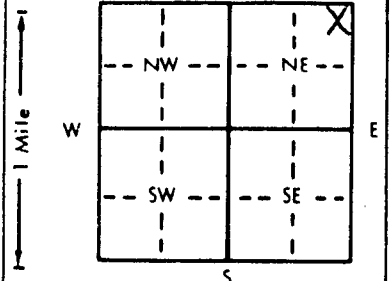

Depth(s) Groundwater Encountered: **1. 7** ft. 2. ... ft. 3. ... ft.  
 WELL'S STATIC WATER LEVEL: **7.87** ft. below land surface measured on mo/day/yr  
 Pump test data: Well water was ... ft. after ... hours pumping ... gpm  
 Est. Yield ... gpm: Well water was ... ft. after ... hours pumping ... gpm  
 Bore Hole Diameter: **7 5/8** in. to **12** ft. and ... in. to ... ft.  
 WELL WATER TO BE USED AS:  
 5 Public water supply 8 Air conditioning 11 Injection well  
 1 Domestic 3 Feedlot 6 Oil field water supply 9 Dewatering 12 Other (Specify below)  
 2 Irrigation 4 Industrial 7 Lawn and garden only **10** Monitoring well  
 Was a chemical/bacteriological sample submitted to Department? Yes... No... **X**; If yes, mo/day/yr sample was submitted  
 Water Well Disinfected? Yes No **X**

5 TYPE OF BLANK CASING USED:  
 1 Steel 3 RMP (SR) 5 Wrought iron 8 Concrete tile CASING JOINTS: Glued ... Clamped ...  
**2** PVC 4 ABS 6 Asbestos-Cement 9 Other (specify below) Welded ...  
 7 Fiberglass Threaded ... **X**

Blank casing diameter: **2** in. to **2** ft., Dia ... in. to ... ft., Dia ... in. to ... ft.  
 Casing height above land surface: **0** in., weight ... lbs./ft. Wall thickness or gauge No. ... sch. **40**

TYPE OF SCREEN OR PERFORATION MATERIAL:  
 1 Steel 3 Stainless steel 5 Fiberglass **7** PVC 10 Asbestos-cement  
 2 Brass 4 Galvanized steel 6 Concrete tile 8 RMP (SR) 11 Other (specify) ...  
 9 ABS 12 None used (open hole)

SCREEN OR PERFORATION OPENINGS ARE:  
 1 Continuous slot **3** Mill slot 5 Gauzed wrapped 8 Saw cut 11 None (open hole)  
 2 Louvered shutter 4 Key punched 6 Wire wrapped 9 Drilled holes  
 7 Torch cut 10 Other (specify) ...

SCREEN-PERFORATED INTERVALS: From **2** ft. to **12** ft., From ... ft. to ... ft.  
 GRAVEL PACK INTERVALS: From **1** ft. to **12** ft., From ... ft. to ... ft.

6 GROUT MATERIAL: 1 Neat cement **2** Cement grout **3** Bentonite 4 Other  
 Grout Intervals: From **0** ft. to **.5** ft., From **.5** ft. to **1** ft., From ... ft. to ... ft.

What is the nearest source of possible contamination:  
 1 Septic tank 4 Lateral lines 7 Pit privy **10** Livestock pens 14 Abandoned water well  
 2 Sewer lines 5 Cess pool 8 Sewage lagoon **11** Fuel storage 15 Oil well/Gas well  
 3 Watertight sewer lines 6 Seepage pit 9 Feedyard 12 Fertilizer storage 16 Other (specify below)  
 13 Insecticide storage  
 Direction from well? **North** How many feet? **20**

FROM	TO	LITHOLOGIC LOG	FROM	TO	PLUGGING INTERVALS
0	6"	Concrete			
6"	8"	Snd, f-c grnd, sl-mod grvl, prly srtd, sl cly v slty moist, med brn			
8'	12'	Snd, f-med grnd, sl c grns, tr of grvl, frly well srtd, md-subang, yell-brn clr			

7 CONTRACTOR'S OR LANDOWNER'S CERTIFICATION: This water well was **1** constructed, **2** reconstructed, or **3** plugged under my jurisdiction and was completed on (mo/day/year) **06-30-94** and this record is true to the best of my knowledge and belief. Kansas Water Well Contractor's License No. **527** This Water Well Record was completed on (mo/day/yr) **07-19-94** under the business name of **GeoCore Services, Inc.** by (signature) *Dale Rold*