WATER WELL RECORD Form WWC-5 KSA 82a-1212

1 LOCATION OF WATER WELL	Fraction	Section Number	Township Number	Range Number
County: Phillips	SE ¼ SE ¼ NW ¼	35	T 3 S	R 18 E W

Distance and direction from nearest town or city? In Phillipsburg City

Street address of well if located within city? 150 - 5th Street

2 WATER WELL OWNER: Paul Beckman

RR#, St. Address, Box # : 150 - 5th Street

City, State, ZIP Code : Phillipsburg, KS 67661

Board of Agriculture, Division of Water Resources Application Number:

3 DEPTH OF COMPLETED WELL 48 ft. Bore Hole Diameter 9½ in. to 48 ft., and ... in. to ... ft.

Well Water to be used as: XX Domestic 2 Irrigation 3 Feedlot 4 Industrial 5 Public water supply 6 Oil field water supply 7 Lawn and garden only 8 Air conditioning 9 Dewatering 10 Observation well 11 Injection well 12 Other (Specify below)

Well's static water level 33 ft. below land surface measured on 5 month ... day 81 year

Pump Test Data : Well water was ... ft. after ... hours pumping ... gpm

Est. Yield 12 gpm: Well water was ... ft. after ... hours pumping ... gpm

4 TYPE OF BLANK CASING USED: 1 Steel XX PVC 3 RMP (SR) 4 ABS 5 Wrought iron 6 Asbestos-Cement 7 Fiberglass 8 Concrete tile 9 Other (specify below)

Casing Joints: Glued X Clamped ... Welded ... Threaded ...

Blank casing dia 6 in. to 48 ft., Dia ... in. to ... ft., Dia ... in. to ... ft.

Casing height above land surface 24 in., weight ... lbs./ft. Wall thickness or gauge No Sch 160

TYPE OF SCREEN OR PERFORATION MATERIAL: 1 Steel 2 Brass 3 Stainless steel 4 Galvanized steel 5 Fiberglass 6 Concrete tile XX PVC 8 RMP (SR) 9 ABS 10 Asbestos-cement 11 Other (specify) ... 12 None used (open hole)

Screen or Perforation Openings Are: 1 Continuous slot 2 Louvered shutter 3 Mill slot 4 Key punched 5 Gauzed wrapped 6 Wire wrapped 7 Torch cut XX 8 Saw cut 9 Drilled holes 10 Other (specify) ... 11 None (open hole)

Screen-Perforation Dia 6 in. to ... ft., Dia ... in. to ... ft., Dia ... in to ... ft.

Screen-Perforated Intervals: From 48 ft. to 38 ft., From ... ft. to ... ft.
From ... ft. to ... ft., From ... ft. to ... ft.

Gravel Pack Intervals: From 48 ft. to 20 ft., From ... ft. to ... ft.
From ... ft. to ... ft., From ... ft. to ... ft.

5 GROUT MATERIAL: XX Neat cement 2 Cement grout 3 Bentonite 4 Other ...

Grouted Intervals: From 20 ft. to 10 ft., From ... ft. to ... ft., From ... ft. to ... ft.

What is the nearest source of possible contamination: 1 Septic tank XX 2 Sewer lines 3 Lateral lines 4 Cess pool 5 Seepage pit 6 Pit privy 7 Sewage lagoon 8 Feed yard 9 Livestock pens 10 Fuel storage 11 Fertilizer storage 12 Insecticide storage 13 Watertight sewer lines 14 Abandoned water well 15 Oil well/Gas well 16 Other (specify below) ...

Direction from well NW How many feet 50 ? Water Well Disinfected? Yes X No

Was a chemical/bacteriological sample submitted to Department? Yes ... No X ... If yes, date sample was submitted ... month ... day ... year: Pump Installed? Yes ... No X

If Yes: Pump Manufacturer's name ... Model No. ... HP ... Volts ...

Depth of Pump Intake ... ft. Pumps Capacity rated at ... gal./min.

Type of pump: 1 Submersible 2 Turbine 3 Jet 4 Centrifugal 5 Reciprocating 6 Other

6 CONTRACTOR'S OR LANDOWNER'S CERTIFICATION: This water well was XX (1) constructed, (2) reconstructed, or (3) plugged under my jurisdiction and was completed on 5 month ... day 81 year, and this record is true to the best of my knowledge and belief. Kansas Water Well Contractor's License No. 344

This Water Well Record was completed on 5 month 7 day 82 year under the business name of Deer Drilling by (signature) William L. Deer

7 LOCATE WELL'S LOCATION WITH AN "X" IN SECTION BOX:

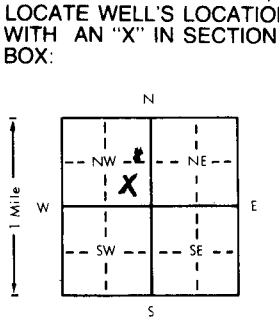

ELEVATION:

FROM	TO	LITHOLOGIC LOG	FROM	TO	LITHOLOGIC LOG
0	4	Top Soil			
4	26	Lt Brown Clay			
26	34	Fine Sand			
34	40	Med Sand - Flint			
40	48	Sandy Clay			
48		Shale			

Depth(s) Groundwater Encountered 1. 22 ft. 2. ... ft. 3. ... ft. 4. ... ft. (Use a second sheet if needed)

INSTRUCTIONS: Use typewriter or ball point pen, *please press firmly* and *PRINT* clearly. Please fill in blanks, underline or circle the correct answers. Send top three copies to Kansas Department of Health and Environment, Division of Environment, Water Well Contractors, Topeka, KS 66620. Send one to WATER WELL OWNER and retain one for your records.

OFFICE USE ONLY