


1 LOCATION OF WATER WELL: County: Phillips Fraction: SE 1/4 NW 1/4 NW 1/4 Section Number: 35 Township Number: T 3 S Range Number: R 18 EW

Distance and direction from nearest town or city street address of well if located within city?
Phillipsburg Kansas

2 WATER WELL OWNER: RR#, St. Address, Box #: ROGER KANPFE 473 3rd City, State, ZIP Code: Phillipsburg Ks. Board of Agriculture, Division of Water Resources Application Number:

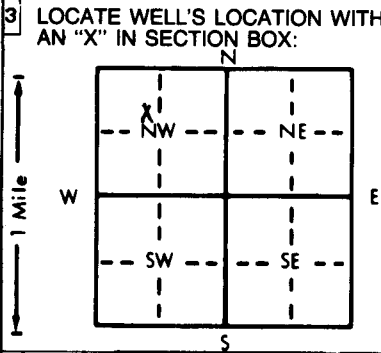

4 DEPTH OF COMPLETED WELL: 78' ft. ELEVATION: ft.
 Depth(s) Groundwater Encountered 1. 63' ft. 2. ft. 3. ft.
 WELL'S STATIC WATER LEVEL: 63' ft. below land surface measured on mo/day/yr 2-8-90
 Pump test data: Well water was 63' ft. after 1 hours pumping 15 gpm
 Est. Yield 15 gpm: Well water was 2' ft. after 1 hours pumping 15 gpm
 Bore Hole Diameter: 10 in. to 63' ft., and in. to ft.
 WELL WATER TO BE USED AS:
 5 Public water supply 8 Air conditioning 11 Injection well
 1 Domestic 3 Feedlot 6 Oil field water supply 9 Dewatering 12 Other (Specify below)
 2 Irrigation 4 Industrial 7 Lawn and garden only 10 Monitoring well
 Was a chemical/bacteriological sample submitted to Department? Yes No ; If yes, mo/day/yr sample was submitted
 Water Well Disinfected? Yes No

5 TYPE OF BLANK CASING USED:
 1 Steel 3 RMP (SR) 5 Wrought iron 8 Concrete tile CASING JOINTS: Glued Clamped
 2 PVC 4 ABS 6 Asbestos-Cement 9 Other (specify below) Welded
 7 Fiberglass Threaded
 Blank casing diameter 5" in. to 78' ft., Dia in. to ft., Dia in. to ft.
 Casing height above land surface 24" in., weight 200# lbs./ft. Wall thickness or gauge No. 14"
 TYPE OF SCREEN OR PERFORATION MATERIAL:
 1 Steel 3 Stainless steel 5 Fiberglass 7 PVC 10 Asbestos-cement
 2 Brass 4 Galvanized steel 6 Concrete tile 8 RMP (SR) 11 Other (specify)
 12 None used (open hole)
 SCREEN OR PERFORATION OPENINGS ARE:
 1 Continuous slot 3 Mill slot 5 Gauzed wrapped 8 Saw cut 11 None (open hole)
 2 Louvered shutter 4 Key punched 6 Wire wrapped 9 Drilled holes
 7 Torch cut 10 Other (specify)
 SCREEN-PERFORATED INTERVALS: From 58' ft. to 78' ft., From ft. to ft.
 From ft. to ft., From ft. to ft.
 GRAVEL PACK INTERVALS: From 58' ft. to 78' ft., From ft. to ft.
 From ft. to ft., From ft. to ft.

6 GROUT MATERIAL: 1 Neat cement 2 Cement grout 3 Bentonite 4 Other
 Grout Intervals: From 0 ft. to 20 ft., From ft. to ft., From ft. to ft.
 What is the nearest source of possible contamination:
 1 Septic tank 4 Lateral lines None 7 Pit privy 10 Livestock pens 14 Abandoned water well
 2 Sewer lines 5 Cess pool 8 Sewage lagoon 11 Fuel storage 15 Oil well/Gas well
 3 Watertight sewer lines 6 Seepage pit 9 Feedyard 12 Fertilizer storage 16 Other (specify below)
 13 Insecticide storage

Direction from well? How many feet?

FROM	TO	LITHOLOGIC LOG	FROM	TO	PLUGGING INTERVALS
0	3	Bl Soil			
3	15	Clay			
15	63	Clay Sand			
63	78	SAND Rock			
78		SHALE			

7 CONTRACTOR'S OR LANDOWNER'S CERTIFICATION: This water well was (1) constructed, (2) reconstructed, or (3) plugged under my jurisdiction and was completed on (mo/day/year) 2-6-90 and this record is true to the best of my knowledge and belief. Kansas Water Well Contractor's License No. 229 This Water Well Record was completed on (mo/day/yr) 2-10-90 under the business name of Redinger Drilling by (signature) Warren Redinger