


1 LOCATION OF WATER WELL: County: PHILLIPS Fraction: NW 1/4 NW 1/4 NE 1/4 Section Number: 35 Township Number: T 3 S Range Number: R 18W EW

Distance and direction from nearest town or city street address of well if located within city? 709 STATE ST PHILLIPSBURG, KS

2 WATER WELL OWNER: LOVES STORES, INC. RR#, St. Address, Box #: 10601 N. PENN OKC, OK City, State, ZIP Code: Board of Agriculture, Division of Water Resources Application Number:

3 LOCATE WELL'S LOCATION WITH AN "X" IN SECTION BOX:

4 DEPTH OF COMPLETED WELL: 50.0 ft. ELEVATION: 1924.44

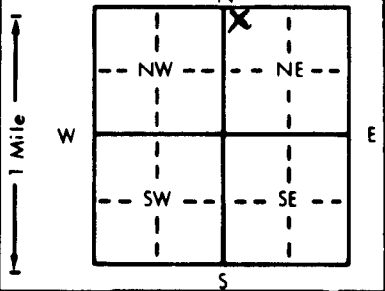

Depth(s) Groundwater Encountered 1. 38.38 ft. 2. ft. 3. ft. WELL'S STATIC WATER LEVEL 38.38 ft. below land surface measured on mo/day/yr 4-2-93 Pump test data: Well water was ft. after hours pumping gpm Est. Yield gpm: Well water was ft. after hours pumping gpm Bore Hole Diameter 8.0 in. to ft. and in. to ft. WELL WATER TO BE USED AS: 5 Public water supply 8 Air conditioning 11 Injection well 1 Domestic 3 Feedlot 6 Oil field water supply 9 Dewatering 12 Other (Specify below) 2 Irrigation 4 Industrial 7 Lawn and garden only 10 Monitoring well Was a chemical/bacteriological sample submitted to Department? Yes No; If yes, mo/day/yr sample was submitted 4-2-93 Water Well Disinfected? Yes No

5 TYPE OF CASING USED: 1 Steel 2 PVC 3 RMP (SR) 4 ABS 5 Wrought iron 6 Asbestos-Cement 7 Fiberglass 8 Concrete tile 9 Other (specify below) CASING JOINTS: Glued Clamped Welded Threaded Blank casing diameter 2.0 in. to 35 ft. Dia in. to ft. Dia in. to ft. Casing height above land surface .52 in., weight 54 lbs./ft. Wall thickness or gauge No. TYPE OF SCREEN OR PERFORATION MATERIAL: 1 Steel 2 Brass 3 Stainless steel 4 Galvanized steel 5 Fiberglass 6 Concrete tile 7 PVC 8 RMP (SR) 9 ABS 10 Asbestos-cement 11 Other (specify) 12 None used (open hole) SCREEN OR PERFORATION OPENINGS ARE: 1 Continuous slot 2 Louvered shutter 3 Mill slot 4 Key punched 5 Gauzed wrapped 6 Wire wrapped 7 Torch cut 8 Saw cut 9 Drilled holes 10 Other (specify) 11 None (open hole)

SCREEN-PERFORATED INTERVALS: From 35 ft. to 50 ft. GRAVEL PACK INTERVALS: From 33 ft. to 50 ft.

6 GROUT MATERIAL: 1 Neat cement 2 Cement grout 3 Bentonite 4 Other Grout Intervals: From 0 ft. to 33 ft. From ft. to ft. From ft. to ft. From ft. to ft. What is the nearest source of possible contamination: 1 Septic tank 2 Sewer lines 3 Watertight sewer lines 4 Lateral lines 5 Cess pool 6 Seepage pit 7 Pit privy 8 Sewage lagoon 9 Feedyard 10 Livestock pens 11 Fuel storage 12 Fertilizer storage 13 Insecticide storage 14 Abandoned water well 15 Oil well/Gas well 16 Other (specify below) Direction from well? SOUTH How many feet? 90'

Table with 4 columns: FROM, TO, LITHOLOGIC LOG, PLUGGING INTERVALS. Row 1: FROM 0, TO 50, LITHOLOGIC LOG CLAY/SILT/SILTY SAND LAYERS, PLUGGING INTERVALS.

7 CONTRACTOR'S OR LANDOWNER'S CERTIFICATION: This water well was (1) constructed, (2) reconstructed, or (3) plugged under my jurisdiction and was completed on (mo/day/year) 3-31-93 and this record is true to the best of my knowledge and belief. Kansas Water Well Contractor's License No. 564 This Water Well Record was completed on (mo/day/yr) 4-7-93 under the business name of NESCO by (signature) John R. Lawt