


1 LOCATION OF WATER WELL: County: **Phillips** Fraction: **NE 1/4 NW 1/4 NW 1/4** Section Number: **36** Township Number: **T 3** S Range Number: **R 18 EW**

Distance and direction from nearest town or city street address of well if located within city?
1/4 mile east of Phillipsburg, Kansas

2 WATER WELL OWNER: **Lee & Betty Woodyard**
 RR#, St. Address, Box #: **Phillipsburg, Kansas 67661**
 City, State, ZIP Code: **Phillipsburg, Kansas 67661**
 Board of Agriculture, Division of Water Resources
 Application Number:

3 LOCATE WELL'S LOCATION WITH AN "X" IN SECTION BOX:

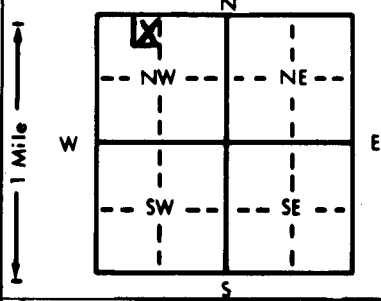

4 DEPTH OF COMPLETED WELL: **56** ft. ELEVATION:

Depth(s) Groundwater Encountered: 1. **43** ft. 2. **56** ft. 3. **5-12-87** ft.
 WELL'S STATIC WATER LEVEL: **43** ft. below land surface measured on mo/day/yr **5-12-87**
 Bore Hole Diameter: **9** in. to **56** ft., and **56** in. to **56** ft.
 WELL WATER TO BE USED AS:
 Domestic 3 Feedlot 6 Oil field water supply 9 Dewatering 12 Other (Specify below)
 2 Irrigation 4 Industrial 7 Lawn and garden only 10 Observation well
 Was a chemical/bacteriological sample submitted to Department? Yes.....No.....; If yes, mo/day/yr sample was submitted
 Water Well Disinfected? Yes No

5 TYPE OF BLANK CASING USED:

Blank casing diameter: **5** in. to **46** in., Dia. **160** lbs./ft. Wall thickness or gauge No.
 Casing height above land surface: **12** in., weight **160** lbs./ft. Wall thickness or gauge No.
 TYPE OF SCREEN OR PERFORATION MATERIAL:
 Steel 3 Stainless steel 5 Fiberglass 8 RMP (SR) 10 Asbestos-cement
 PVC 7 Fiberglass 9 ABS 11 Other (specify) 12 None used (open hole)
 SCREEN OR PERFORATION OPENINGS ARE:
 1 Continuous slot 3 Mill slot 5 Gauzed wrapped 8 Saw cut 11 None (open hole)
 2 Louvered shutter 4 Key punched 6 Wire wrapped 9 Drilled holes
 7 Torch cut 10 Other (specify)
 SCREEN-PERFORATED INTERVALS: From **46** ft. to **56** ft., From **20** ft. to **56** ft.
 GRAVEL PACK INTERVALS: From **20** ft. to **56** ft., From **20** ft. to **56** ft.

6 GROUT MATERIAL: 1 Neat cement 2 Cement grout 3 Bentonite 4 Other

Grout Intervals: From **10** ft. to **30** ft., From **30** ft. to **56** ft., From **30** ft. to **56** ft., From **30** ft. to **56** ft.
 What is the nearest source of possible contamination:
 1 Septic tank 4 Lateral lines 7 Pit privy 10 Livestock pens 14 Abandoned water well
 2 Sewer lines 5 Cess pool 8 Sewage lagoon 11 Fuel storage 15 Oil well/Gas well
 3 Watertight sewer lines 6 Seepage pit 9 Feedyard 12 Fertilizer storage 16 Other (specify below)
 13 Insecticide storage
 Direction from well? **West** How many feet? **15 ft**

FROM	TO	LITHOLOGIC LOG	FROM	TO	LITHOLOGIC LOG
0	39	Clay			
		some sandstone layers			
39	42	Sand			
42	54	Sand & rock layers			
54	56	shale			

7 CONTRACTOR'S OR LANDOWNER'S CERTIFICATION: This water well was constructed, (2) reconstructed, or (3) plugged under my jurisdiction and was completed on (mo/day/year) **5-12-87** and this record is true to the best of my knowledge and belief. Kansas

Water Well Contractor's License No. **386** This Water Well Record was completed on (mo/day/yr) **6-1-87**
 under the business name of **OTT Enterprises** by (signature) **Paul Ott**