


1 LOCATION OF WATER WELL: County: Phillips Fraction: NW 1/4 SE 1/4 SE 1/4 Section Number: 36 Township Number: T 3 S Range Number: R 18 EW
 Distance and direction from nearest town or city street address of well if located within city?
1/2 mile South 1/2 East Phillipsburg, Ks

2 WATER WELL OWNER: RR#, St. Address, Box #: Rejon Braun Rt 3 Board of Agriculture, Division of Water Resources
 City, State, ZIP Code: Phillipsburg Kansas 67661 Application Number:

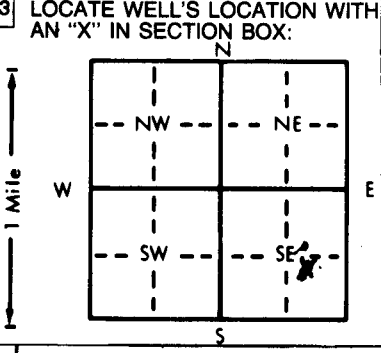

4 DEPTH OF COMPLETED WELL: 46' ft. ELEVATION: ft.
 Depth(s) Groundwater Encountered 1. 30' ft. 2. ft. 3. ft.
 WELL'S STATIC WATER LEVEL 30' ft. below land surface measured on mo/day/yr 6-3-87
 Pump test data: Well water was 30' ft. after 1 hours pumping 10 gpm
 Est. Yield 10 gpm: Well water was 25' ft. after 2 hours pumping 10 gpm
 Bore Hole Diameter 1.1 in. to ft., and in. to ft.
 WELL WATER TO BE USED AS:
 1 Domestic 3 Feedlot 6 Oil field water supply 9 Dewatering 12 Other (Specify below)
 2 Irrigation 4 Industrial 7 Lawn and garden only 10 Observation well
 Was a chemical/bacteriological sample submitted to Department? Yes.....No X.....; If yes, mo/day/yr sample was submitted
 Water Well Disinfected? Yes X No

5 TYPE OF BLANK CASING USED:
 1 Steel 3 RMP (SR) 5 Wrought iron 8 Concrete tile CASING JOINTS: Glued X Clamped
 2 PVC 4 ABS 6 Asbestos-Cement 9 Other (specify below) Welded
 Blank casing diameter 5" in. to 4.6' ft., Dia. in. to ft., Dia. in. to ft.
 Casing height above land surface 2' in., weight 200* lbs./ft. Wall thickness or gauge No. 14
 TYPE OF SCREEN OR PERFORATION MATERIAL:
 1 Steel 3 Stainless steel 5 Fiberglass 7 PVC 10 Asbestos-cement
 2 Brass 4 Galvanized steel 6 Concrete tile 8 RMP (SR) 11 Other (specify)
 SCREEN OR PERFORATION OPENINGS ARE:
 1 Continuous slot 3 Mill slot 5 Gauzed wrapped 8 Saw cut 11 None (open hole)
 2 Louvered shutter 4 Key punched 6 Wire wrapped 9 Drilled holes
 7 Torch cut 10 Other (specify)
 SCREEN-PERFORATED INTERVALS: From 26' ft. to 46' ft., From ft. to ft.
 From ft. to ft., From ft. to ft.
 GRAVEL PACK INTERVALS: From 20' ft. to 46' ft., From ft. to ft.
 From ft. to ft., From ft. to ft.

6 GROUT MATERIAL: 1 Neat cement 2 Cement grout 3 Bentonite 4 Other
 Grout Intervals: From 0 ft. to 20 ft., From ft. to ft., From ft. to ft.
 What is the nearest source of possible contamination:
 1 Septic tank 4 Lateral lines None 7 Pit privy 10 Livestock pens 14 Abandoned water well
 2 Sewer lines 5 Cess pool 8 Sewage lagoon 11 Fuel storage 15 Oil well/Gas well
 3 Watertight sewer lines 6 Seepage pit 9 Feedyard 12 Fertilizer storage 16 Other (specify below)
 13 Insecticide storage
 Direction from well? How many feet?

FROM	TO	LITHOLOGIC LOG	FROM	TO	LITHOLOGIC LOG
0	5	30 Soil			
5	35	Clay			
35	46	Sand Gravel			
	46	Shale			

7 CONTRACTOR'S OR LANDOWNER'S CERTIFICATION: This water well was (1) constructed, (2) reconstructed, or (3) plugged under my jurisdiction and was completed on (mo/day/year) 6-3-87 and this record is true to the best of my knowledge and belief. Kansas
 Water Well Contractor's License No. 229 This Water Well Record was completed on (mo/day/yr) 6-21-87
 under the business name of Rejon Braun Drillers by (signature) Rejon Braun
 INSTRUCTIONS: Use typewriter or ball point pen, PLEASE PRESS FIRMLY and PRINT clearly. Please fill in blanks, underline or circle the correct answers. Send top three copies to Kansas Department of Health and Environment, Division of Environment, Environmental Geology Section, Topeka, KS 66620. Send one to WATER WELL OWNER and retain one for your records.