


1 LOCATION OF WATER WELL: Fraction Section Number Township Number Range Number
 County: Phillips S W 1/4 S 27 1/4 S 27 1/4 21 3 18

Distance and direction from nearest town or city street address of well if located within city?
1 1/2 miles West Phillipsburg N side US 36

2 WATER WELL OWNER:
 RR#, St. Address, Box #: Dan Beyenlein Board of Agriculture, Division of Water Resources
 City, State, ZIP Code: 1543 W 100 Phillipsburg Application Number: 1367661

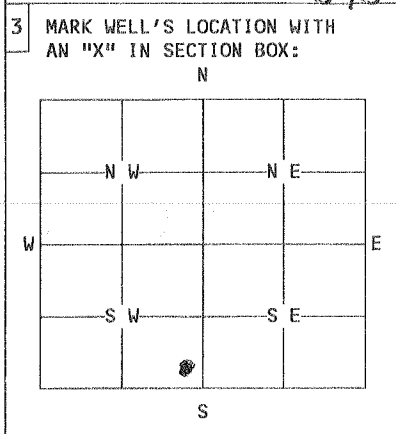

4 DEPTH OF WELL.....ft. 80
 WELL'S STATIC WATER LEVEL.....ft. 50
 WELL WAS USED AS:

<input checked="" type="checkbox"/> 1 Domestic	<input type="checkbox"/> 5 Public Water Supply	<input type="checkbox"/> 9 Dewatering
<input type="checkbox"/> 2 Irrigation	<input type="checkbox"/> 6 Oil Field Water Supply	<input type="checkbox"/> 10 Monitoring Well
<input type="checkbox"/> 3 Feedlot	<input type="checkbox"/> 7 Lawn and Garden Only	<input type="checkbox"/> 11 Injection Well
<input type="checkbox"/> 4 Industrial	<input type="checkbox"/> 8 Air Conditioning	<input type="checkbox"/> 12 Other.....

 Was a chemical/bacteriological sample submitted to Department? Yes..... No.....
 If yes, mo/day/yr sample was submitted.....
 Water Well Disinfected: Yes..... No.....

5 TYPE OF BLANK CASING USED:

<input type="checkbox"/> 1 Steel	<input type="checkbox"/> 3 RMP (SR)	<input type="checkbox"/> 5 Wrought	<input type="checkbox"/> 7 Fiberglass	<input type="checkbox"/> 9 Other (specify below)
<input type="checkbox"/> 2 PVC	<input type="checkbox"/> 4 ABS	<input type="checkbox"/> 6 Asbestos-Cement	<input type="checkbox"/> 8 Concrete Tile	<u>C.I.P. to 10 ft</u>

 Blank casing diameter.....6.....in. Was casing pulled? Yes..... No..... If yes, how much.....
 Casing height above or below land surface.....4 ft.....in.

6 GROUT PLUG MATERIAL: 1 Neat cement 2 Cement grout 3 Bentonite 4 Other.....Gravel.....
 Grout Plug Intervals: From 80 ft. to 60 ft., From 61 ft. to 51 ft., From 51 to 0 ft.
 What is the nearest source of possible contamination: Gravel Bentonite Cement

<input type="checkbox"/> 1 Septic tank	<input type="checkbox"/> 6 Seepage pit	<input type="checkbox"/> 11 Fuel storage	<input type="checkbox"/> 16 Other (specify below)
<input type="checkbox"/> 2 Sewer lines	<input type="checkbox"/> 7 Pit privy	<input type="checkbox"/> 12 Fertilizer storage
<input type="checkbox"/> 3 Watertight sewer lines	<input checked="" type="checkbox"/> 8 Sewage lagoon	<input type="checkbox"/> 13 Insecticide storage
<input type="checkbox"/> 4 Lateral lines	<input checked="" type="checkbox"/> 9 Feedyard	<input type="checkbox"/> 14 Abandoned water well
<input type="checkbox"/> 5 Cess Pool	<input checked="" type="checkbox"/> 10 Livestock pens	<input type="checkbox"/> 15 Oil well/Gas well

 Direction from well? N..... How many feet? 5 ft.....

FROM	TO	PLUGGING MATERIALS
80	60	Gravel
61	51	Bentonite
51	0	Cement

6PS

39.77268

-99.35639

Garman

7 CONTRACTOR'S OR LANDOWNER'S CERTIFICATION: This water well was plugged under my jurisdiction and was completed on (mo/day/year) Sept 22 2015 and this record is true to the best of my knowledge and belief. Kansas Water Well Contractor's License No. NA This Water Well Record was completed on (mo/day/year) Sept 22 2015 under the business name of
 by (signature) Dan Beyenlein

INSTRUCTIONS: Use typewriter or ball point pen. Please press firmly and print clearly. Please fill in blanks, underline or circle the correct answers. Send top three copies to Kansas Department of Health and Environment, Bureau of Water, Topeka, Kansas 66620-0001. Telephone: 913/296-3565. Send one to Water Well Owner and retain one for your records.