


1 LOCATION OF WATER WELL: Fraction *NE 1/4 SW 1/4 NW 1/4* Section Number *25* Township Number *T 3 S* Range Number *R 18 EW*  
 County: *Phillips*

Distance and direction from nearest town or city street address of well if located within city?  
*One 1/2 mile East of Phillipsburg Kansas*

2 WATER WELL OWNER: *Charles Mayer*  
 RR#, St. Address, Box #: *875 Park Phillipsburg Kansas*  
 City, State, ZIP Code: \_\_\_\_\_  
 Board of Agriculture, Division of Water Resources  
 Application Number: \_\_\_\_\_

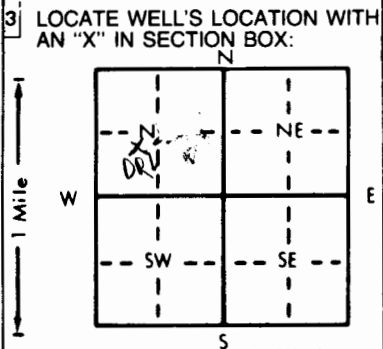

4 DEPTH OF COMPLETED WELL: *50* ft. ELEVATION: \_\_\_\_\_  
 Depth(s) Groundwater Encountered: *1 55* ft. 2. \_\_\_\_\_ ft. 3. \_\_\_\_\_ ft.  
 WELL'S STATIC WATER LEVEL: *55* ft. below land surface measured on *9-14-94* mo/day/yr  
 Pump test data: Well water was \_\_\_\_\_ ft. after \_\_\_\_\_ hours pumping \_\_\_\_\_ gpm  
 Est. Yield: *5* gpm: Well water was \_\_\_\_\_ ft. after \_\_\_\_\_ hours pumping \_\_\_\_\_ gpm  
 Bore Hole Diameter: *10* in. to *20* ft., and \_\_\_\_\_ in. to \_\_\_\_\_ ft.  
 WELL WATER TO BE USED AS:  
 1 Domestic     3 Feedlot     6 Oil field water supply     9 Dewatering     12 Other (Specify below)  
 2 Irrigation     4 Industrial     7 Lawn and garden only     10 Monitoring well  
 Was a chemical/bacteriological sample submitted to Department? Yes \_\_\_\_\_ No ; If yes, mo/day/yr sample was submitted \_\_\_\_\_  
 Water Well Disinfected? Yes \_\_\_\_\_ No

5 TYPE OF BLANK CASING USED:  
 1 Steel     3 RMP (SR)     6 Asbestos-Cement     9 Other (specify below)     Welded  
 PVC     4 ABS     Fiberglass     Threaded  
 Blank casing diameter: *50* in. to *50* ft. Dia. \_\_\_\_\_ in. to \_\_\_\_\_ ft. Dia. \_\_\_\_\_ in. to \_\_\_\_\_ ft.  
 Casing height above land surface: *24* in., weight *160* lbs./ft. Wall thickness or gauge No. \_\_\_\_\_  
 TYPE OF SCREEN OR PERFORATION MATERIAL:  
 1 Steel     3 Stainless steel     5 Fiberglass     8 RMP (SR)     11 Other (specify) \_\_\_\_\_  
 2 Brass     4 Galvanized steel     6 Concrete tile     9 ABS     12 None used (open hole)  
 SCREEN OR PERFORATION OPENINGS ARE:  
 1 Continuous slot     3 Mill slot     6 Wire wrapped     9 Drilled holes  
 2 Louvered shutter     4 Key punched     7 Torch cut     10 Other (specify) \_\_\_\_\_  
 SCREEN-PERFORATED INTERVALS: From *50* ft. to *70* ft., From \_\_\_\_\_ ft. to \_\_\_\_\_ ft.  
 GRAVEL PACK INTERVALS: From *40* ft. to *70* ft., From \_\_\_\_\_ ft. to \_\_\_\_\_ ft.

6 GROUT MATERIAL:  1 Neat cement     2 Cement grout     3 Bentonite     4 Other \_\_\_\_\_  
 Grout intervals: From *0* ft. to *40* ft., From \_\_\_\_\_ ft. to \_\_\_\_\_ ft.  
 What is the nearest source of possible contamination:  
 1 Septic tank     4 Lateral lines     7 Pit privy     10 Livestock pens     14 Abandoned water well  
 2 Sewer lines     5 Cess pool     8 Sewage lagoon     11 Fuel storage     15 Oil well/Gas well  
 3 Watertight sewer lines     6 Seepage pit     9 Feedyard     12 Fertilizer storage     16 Other (specify below) *none*  
 13 Insecticide storage

Direction from well? \_\_\_\_\_ How many feet? \_\_\_\_\_

FROM	TO	LITHOLOGIC LOG	FROM	TO	PLUGGING INTERVALS
<i>0</i>	<i>8</i>	<i>Surface Clay</i>			
<i>8</i>	<i>26</i>	<i>Hard Gray Clay</i>			
<i>26</i>	<i>35</i>	<i>Soft sand</i>			
<i>35</i>	<i>45</i>	<i>Hard yellow clay</i>			
<i>45</i>	<i>55</i>	<i>White soft clay</i>			
<i>55</i>	<i>65</i>	<i>Hard Gray Clay or slab</i>			
<i>65</i>	<i>70</i>				

7 CONTRACTOR'S OR LANDOWNER'S CERTIFICATION: This water well was (1) constructed, (2) reconstructed, or (3) plugged under my jurisdiction and was completed on (mo/day/year) *9-14-94* and this record is true to the best of my knowledge and belief. Kansas Water Well Contractor's License No. *444* This Water Well Record was completed on (mo/day/yr) *9-14-94* under the business name of *Andrew Drilling* by (signature) *Andrew Drilling*

OFFICE USE ONLY  
T  
R  
EW  
SEC.  
1/4  
1/4  
1/4