


MW-3

1 LOCATION OF WATER WELL: County: Phillips Fraction: SW 1/4 SE 1/4 SE 1/4 Section Number: 15 Township Number: T 3 S Range Number: R 19 E/W

Distance and direction from nearest town or city street address of well if located within city?  
NE corner of Kansas and Main Streets, Stuttgart, Kansas

2 WATER WELL OWNER: E mm anuel Church  
RR#, St. Address, Box # :  
City, State, ZIP Code : Stuttgart, Kansas  
Board of Agriculture, Division of Water Resources  
Application Number:

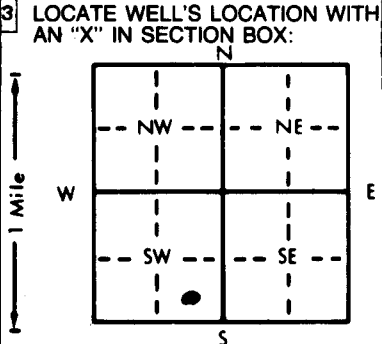

4 DEPTH OF COMPLETED WELL: 65 FT ELEVATION:  
Depth(s) Groundwater Encountered 1. 24.53 FT ft. 2. ft. 3. ft.  
WELL'S STATIC WATER LEVEL 24.53 FT ft. below land surface measured on mo/day/yr 1-23-96  
Pump test data: Well water was ft. after hours pumping gpm  
Est. Yield gpm: Well water was ft. after hours pumping gpm  
Bore Hole Diameter 10 IN in. to ft., and in. to ft.  
WELL WATER TO BE USED AS:  
5 Public water supply 8 Air conditioning 11 Injection well  
1 Domestic 3 Feedlot 6 Oil field water supply 9 Dewatering 12 Other (Specify below)  
2 Irrigation 4 Industrial 7 Lawn and garden only 10 Monitoring well  
Was a chemical/bacteriological sample submitted to Department? Yes No; If yes, mo/day/yr sample was submitted  
Water Well Disinfected? Yes No

5 TYPE OF BLANK CASING USED:  
1 Steel 3 RMP (SR) 5 Wrought iron 8 Concrete tile CASING JOINTS: Glued Clamped  
2 PVC 4 ABS 6 Asbestos-Cement 9 Other (specify below) Welded  
7 Fiberglass Threaded  
Blank casing diameter 2 in. to 4.5 ft., Dia in. to ft., Dia in. to ft.  
Casing height above land surface 0 in., weight lbs./ft. Wall thickness or gauge No. 40  
TYPE OF SCREEN OR PERFORATION MATERIAL:  
1 Steel 3 Stainless steel 5 Fiberglass 8 RMP (SR) 10 Asbestos-cement  
2 Brass 4 Galvanized steel 6 Concrete tile 9 ABS 11 Other (specify)  
12 None used (open hole)  
SCREEN OR PERFORATION OPENINGS ARE:  
1 Continuous slot 3 Mill slot 5 Gauzed wrapped 8 Saw cut 11 None (open hole)  
2 Louvered shutter 4 Key punched 6 Wire wrapped 9 Drilled holes  
7 Torch cut 10 Other (specify)  
SCREEN-PERFORATED INTERVALS: From 4.5 ft. to 65 ft., From ft. to ft.  
From ft. to ft., From ft. to ft.  
GRAVEL PACK INTERVALS: From 4.3 ft. to 65 ft., From ft. to ft.  
From ft. to ft., From ft. to ft.

6 GROUT MATERIAL: 1 Neat cement 2 Cement grout 3 Bentonite 4 Other SEAL 4.1 to 4.3 FT  
Grout Intervals: From 3 ft. to 4.1 ft., From ft. to ft., From ft. to ft.  
What is the nearest source of possible contamination:  
1 Septic tank 4 Lateral lines 7 Pit privy 11 Fuel storage 14 Abandoned water well  
2 Sewer lines 5 Cess pool 8 Sewage lagoon 12 Fertilizer storage 15 Oil well/Gas well  
3 Watertight sewer lines 6 Seepage pit 9 Feedyard 13 Insecticide storage 16 Other (specify below)

Direction from well? How many feet?

FROM	TO	LITHOLOGIC LOG	FROM	TO	PLUGGING INTERVALS
0	8	Sand: Fine gr. Silty sand, Dry.			
8	9	Silt: Brown, dry, sandy silt.			
9	10	Clay: Brown, firm, plastic, sandy clay.			
10	15	Sand: Brown, fine gr. silty sand			
15	20	Silt: Brown sandy silt.			
20	25	Silt: Brown sandy silt. Zone of coarse sand			
25	65	Sand: Brown silty sand			

7 CONTRACTOR'S OR LANDOWNER'S CERTIFICATION: This water well was 1 constructed, (2) reconstructed, or (3) plugged under my jurisdiction and was completed on (mo/day/year) 1-10-96 and this record is true to the best of my knowledge and belief. Kansas Water Well Contractor's License No. Allied Labs 524 This Water Well Record was completed on (mo/day/yr) 1/10/96 under the business name of \_\_\_\_\_ by (signature) Robert Brownell

INSTRUCTIONS: Use typewriter or ball point pen. PLEASE PRESS FIRMLY and PRINT clearly. Please fill in blanks, underline or circle the correct answers. Send top three copies to Kansas Department of Health and Environment, Bureau of Water, Topeka, Kansas 66620-0001. Telephone: 913-296-5545. Send one to WATER WELL OWNER and retain one for your records.