


MW-4

1] LOCATION OF WATER WELL: Fraction NW 1/4 NW 1/4 NE 1/4 Section Number 15 Township Number T 3 S Range Number R 19 E 7W
 County: Phillips

Distance and direction from nearest town or city street address of well if located within city?
Approx. 50 FT From Intersection (NE corner) of east and south easements adjacent to Stuttgart

2] WATER WELL OWNER: Mr. Larry Kellerman
 RR#, St. Address, Box #: P.O. Box 9 Board of Agriculture, Division of Water Resources
 City, State, ZIP Code: Stuttgart, KS Application Number:

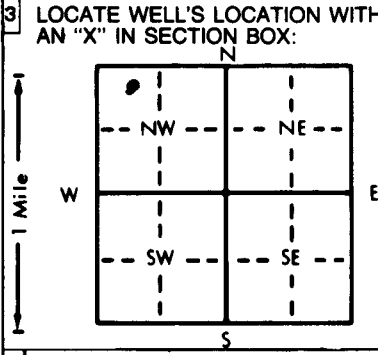

4] DEPTH OF COMPLETED WELL: 60 FT ft. ELEVATION:
 Depth(s) Groundwater Encountered 1. 21.40 FT ft. 2. ft. 3. ft.
 WELL'S STATIC WATER LEVEL 21.40 FT ft. below land surface measured on mo/day/yr 1-24-96
 Pump test data: Well water was ft. after hours pumping gpm
 Est. Yield gpm: Well water was ft. after hours pumping gpm
 Bore Hole Diameter: 10 in. to ft., and in. to ft.
 WELL WATER TO BE USED AS:
 5 Public water supply 8 Air conditioning 11 Injection well
 1 Domestic 3 Feedlot 6 Oil field water supply 9 Dewatering 12 Other (Specify below)
 2 Irrigation 4 Industrial 7 Lawn and garden only 10 Monitoring well
 Was a chemical/bacteriological sample submitted to Department? Yes No; If yes, mo/day/yr sample was submitted
 Water Well Disinfected? Yes No

5] TYPE OF BLANK CASING USED:
 1 Steel PVC 3 RMP (SR) 4 ABS 5 Wrought iron 6 Asbestos-Cement 7 Fiberglass 8 Concrete tile 9 Other (specify below) CASING JOINTS: Glued Clamped
 Blank casing diameter 2 in. to 40 ft., Dia in. to ft., Dia in. to ft.
 Casing height above land surface 0 in., weight lbs./ft. Wall thickness or gauge No. 40
 TYPE OF SCREEN OR PERFORATION MATERIAL:
 1 Steel 3 Stainless steel 5 Fiberglass 8 RMP (SR) 10 Asbestos-cement
 2 Brass 4 Galvanized steel 6 Concrete tile 9 ABS 11 Other (specify)
 12 None used (open hole)
 SCREEN OR PERFORATION OPENINGS ARE:
 1 Continuous slot 3 Mill slot 5 Gauzed wrapped 8 Saw cut 11 None (open hole)
 2 Louvered shutter 4 Key punched 7 Torch cut 10 Other (specify)
 SCREEN-PERFORATED INTERVALS: From 40 ft. to 60 ft., From ft. to ft.
 From ft. to ft., From ft. to ft.
 GRAVEL PACK INTERVALS: From 38 ft. to 60 ft., From ft. to ft.
 From ft. to ft., From ft. to ft.

6] GROUT MATERIAL: 1 Neat cement 2 Cement/grout 3 Bentonite 4 Other SEAL 34-36
 Grout Intervals: From 3 ft. to 34 ft., From ft. to ft., From ft. to ft.
 What is the nearest source of possible contamination:
 1 Septic tank 4 Lateral lines 7 Pit privy 11 Fuel storage 14 Abandoned water well
 2 Sewer lines 5 Cess pool 8 Sewage lagoon 12 Fertilizer storage 15 Oil well/Gas well
 3 Watertight sewer lines 6 Seepage pit 9 Feedyard 13 Insecticide storage 16 Other (specify below)

Direction from well? How many feet?

FROM	TO	LITHOLOGIC LOG	FROM	TO	PLUGGING INTERVALS
0	10	Sand: Brn., v. fine gr. silty sand			
10	15	Sand: Brn, fine to coarse gr. silty sand			
15	20	Sand: Brn, fine gr. silty sand			
20	25	Sand: Brn, fine gr. silty sand Zones of coarse gr. sand			
25	60	Sand: Brn, silty sand			

7] CONTRACTOR'S OR LANDOWNER'S CERTIFICATION: This water well was (1) constructed, (2) reconstructed, or (3) plugged under my jurisdiction and was completed on (mo/day/year) 1-22-96 and this record is true to the best of my knowledge and belief. Kansas Water Well Contractor's License No. 524 This Water Well Record was completed on (mo/day/yr) 1/22/96 under the business name of Allied Labs by (signature) Robert Brownell

INSTRUCTIONS: Use typewriter or ball point pen. PLEASE PRESS FIRMLY and PRINT clearly. Please fill in blanks, underline or circle the correct answers. Send top three copies to Kansas Department of Health and Environment, Bureau of Water, Topeka, Kansas 66620-0001. Telephone: 913-296-5545. Send one to WATER WELL OWNER and retain one for your records.