


MW-9

1 LOCATION OF WATER WELL: Fraction NE 1/4 NW 1/4 NE 1/4 Section Number 15 Township Number T 3 S Range Number R 19 EW

Distance and direction from nearest town or city street address of well if located within city? Located approx. 200 FT SE of MW-7, in grass covered field. Near south side of Main.

2 WATER WELL OWNER: RR#, St. Address, Box #: Stuttgart, KS City, State, ZIP Code: Stuttgart, KS Board of Agriculture, Division of Water Resources Application Number:

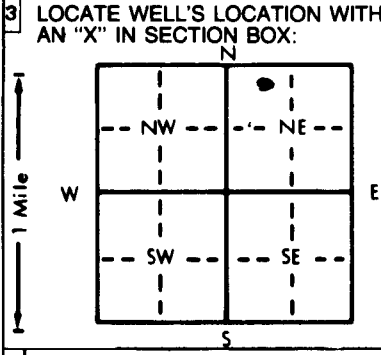

3 LOCATE WELL'S LOCATION WITH AN 'X' IN SECTION BOX: 4 DEPTH OF COMPLETED WELL: 62 FT. ft. ELEVATION: 28.75 FT. ft. 2. Depth(s) Groundwater Encountered: 28.75 FT. ft. 3. WELL'S STATIC WATER LEVEL: 28.75 FT. ft. below land surface measured on mo/day/yr 1-24-96. Pump test data: Well water was ... ft. after ... hours pumping ... gpm. Est. Yield ... gpm. Well water was ... ft. after ... hours pumping ... gpm. Bore Hole Diameter 10 IN. in. to ... ft., and ... in. to ... ft. WELL WATER TO BE USED AS: 5 Public water supply 8 Air conditioning 11 Injection well 1 Domestic 3 Feedlot 6 Oil field water supply 9 Dewatering 12 Other (Specify below) 2 Irrigation 4 Industrial 7 Lawn and garden only 10 Monitoring well. Was a chemical/bacteriological sample submitted to Department? Yes (No); If yes, mo/day/yr sample was submitted. Water Well Disinfected? Yes (No)

5 TYPE OF BLANK CASING USED: 1 Steel 3 RMP (SR) 5 Wrought iron 8 Concrete tile CASING JOINTS: Glued Clamped 2 PVC 4 ABS 6 Asbestos-Cement 9 Other (specify below) Welded 7 Fiberglass Threaded

Blank casing diameter 2 in. to ... ft., Dia. ... in. to ... ft., Dia. ... in. to ... ft. Casing height above land surface 3 FT. in., weight ... lbs./ft. Wall thickness or gauge No. 10

TYPE OF SCREEN OR PERFORATION MATERIAL: 1 Steel 3 Stainless steel 5 Fiberglass 8 RMP (SR) 10 Asbestos-cement 2 Brass 4 Galvanized steel 6 Concrete tile 9 ABS 11 Other (specify) 12 None used (open hole)

SCREEN OR PERFORATION OPENINGS ARE: 1 Continuous slot 3 Mill slot 5 Gauzed wrapped 8 Saw cut 11 None (open hole) 2 Louvered shutter 4 Key punched 6 Wire wrapped 9 Drilled holes 7 Torch cut 10 Other (specify)

SCREEN-PERFORATED INTERVALS: From 42 FT ft. to 62 FT ft., From ... ft. to ... ft. GRAVEL PACK INTERVALS: From 70 FT ft. to 62 FT ft., From ... ft. to ... ft.

6 GROUT MATERIAL: 1 Neat cement 2 Cement grout 3 Bentonite 4 Other SEAL: 38-40 FT. Grout intervals: From ... ft. to ... ft., From ... ft. to ... ft., From ... ft. to ... ft.

What is the nearest source of possible contamination: 1 Septic tank 4 Lateral lines 7 Pit privy 11 Fuel storage 14 Abandoned water well 2 Sewer lines 5 Cess pool 8 Sewage lagoon 12 Fertilizer storage 15 Oil well/Gas well 3 Watertight sewer lines 6 Seepage pit 9 Feedyard 13 Insecticide storage 16 Other (specify below)

Direction from well? How many feet? LITHOLOGIC LOG FROM TO FROM TO PLUGGING INTERVALS

FROM	TO	LITHOLOGIC LOG	FROM	TO	PLUGGING INTERVALS
0	8	Silt: Brown sandy/clay silt.			
8	10	Clay: Brown, sandy/silty clay			
10	15	Sand: Brown, silty fine sand			
15	25	Sand: Brown, silty fine sand and silt. Zones of coarse grey sand			
25	62	Sand: Brown silty sand			

7 CONTRACTOR'S OR LANDOWNER'S CERTIFICATION: This water well was (1) constructed, (2) reconstructed, or (3) plugged under my jurisdiction and was completed on (mo/day/year) 1-16-96 and this record is true to the best of my knowledge and belief. Kansas Water Well Contractor's License No. 524 This Water Well Record was completed on (mo/day/yr) 1/16/96 under the business name of Allied Labs by (signature) Robert Crowell