


MW-11

1 LOCATION OF WATER WELL: Fraction NW 1/4 NE 1/4 NW 1/4 Section Number 15 Township Number T 3 S Range Number R 19 E W  
 County: Phillips

Distance and direction from nearest town or city street address of well if located within city?  
Stuttgart Oil Co. P.O. Box 9, Stuttgart KS SE corner of Kansas and Main

2 WATER WELL OWNER: Stuttgart Oil Co  
 RR#, St. Address, Box #: PO Box 9  
 City, State, ZIP Code: Stuttgart, KS  
 Board of Agriculture, Division of Water Resources  
 Application Number: 1992-001

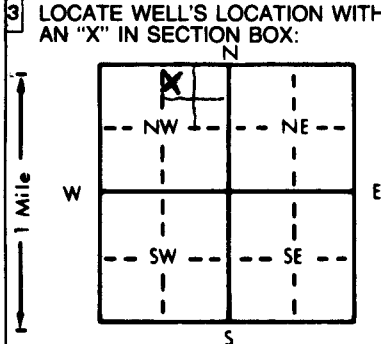

4 DEPTH OF COMPLETED WELL: 26.12 ft. ELEVATION: 1992.00 FT  
 Depth(s) Groundwater Encountered: 23.81 FT ft. 2. .... ft. 3. .... ft.  
 WELL'S STATIC WATER LEVEL: 23.81 FT ft. below land surface measured on mo/day/yr 9-26-96  
 Pump test data: Well water was ..... ft. after ..... hours pumping ..... gpm  
 Est. Yield ..... gpm: Well water was ..... ft. after ..... hours pumping ..... gpm  
 Bore Hole Diameter: 7.25 in. to ..... ft., and ..... in. to ..... ft.  
 WELL WATER TO BE USED AS:  
 5 Public water supply 8 Air conditioning 11 Injection well  
 1 Domestic 3 Feedlot 6 Oil field water supply 9 Dewatering 12 Other (Specify below)  
 2 Irrigation 4 Industrial 7 Lawn and garden only 10 Monitoring well  
 Was a chemical/bacteriological sample submitted to Department? Yes.....No. X.....; If yes, mo/day/yr sample was submitted  
 Water Well Disinfected? Yes No X

5 TYPE OF BLANK CASING USED:  
 1 Steel 2 PVC 3 RMP (SR) 4 ABS  
 5 Wrought iron 6 Asbestos-Cement 7 Fiberglass 8 Concrete tile 9 Other (specify below)  
 Blank casing diameter: 2 IN in. to 16.12 ft., Dia. .... in. to ..... ft., Dia. .... in. to ..... ft.  
 Casing height above land surface: 0 FT in., weight 4 lbs./ft. Wall thickness or gauge No. 40  
 TYPE OF SCREEN OR PERFORATION MATERIAL:  
 1 Steel 2 Brass 3 Stainless steel 4 Galvanized steel 5 Fiberglass 6 Concrete tile 7 PVC 8 RMP (SR) 9 ABS 10 Asbestos-cement 11 Other (specify) 12 None used (open hole)  
 SCREEN OR PERFORATION OPENINGS ARE:  
 1 Continuous slot 2 Louvered shutter 3 Mill slot 4 Key punched 5 Gauzed wrapped 6 Wire wrapped 7 Torch cut 8 Saw cut 9 Drilled holes 10 Other (specify) 11 None (open hole)  
 SCREEN-PERFORATED INTERVALS: From 16.12 ft. to 26.12 ft., From ..... ft. to ..... ft.  
 GRAVEL PACK INTERVALS: From 14 ft. to 26.12 ft., From ..... ft. to ..... ft.

6 GROUT MATERIAL: 1 Neat cement 2 Cement grout 3 Bentonite 4 Other Bentonite Seal (12-14)  
 Grout intervals: From 1 ft. to 14 ft., From ..... ft. to ..... ft., From ..... ft. to ..... ft.  
 What is the nearest source of possible contamination:  
 1 Septic tank 2 Sewer lines 3 Watertight sewer lines 4 Lateral lines 5 Cess pool 6 Seepage pit 7 Pit privy 8 Sewage lagoon 9 Feedyard 10 Livestock pens 11 Fuel storage 12 Fertilizer storage 13 Insecticide storage 14 Abandoned water well 15 Oil well/Gas well 16 Other (specify below)

Direction from well? How many feet?

FROM	TO	LITHOLOGIC LOG	FROM	TO	PLUGGING INTERVALS
0	0.5	Dk. brn. dry sandy silt			
0.5	1.0	Gravel			
1.0	2.0	Dk. brn moist clay silt			
2.0	4.0	Brn. moist clay silt			
4.0	5.0	Brn. moist sandy silt			
5.0	9.0	Brn. moist clay silt, Caliche.			
9.0	10.0	Brn soft moist silt			
10.0	14.0	Brn. moist sandy silt			
14.0	16.0	Brn. moist coarse gr. silty sand			
16.0	20.0	Brn. soft moist sandy silt zones of silty sand			
20.0	25.0	Brown soft moist sandy silt			
25.0	26.12	Same			

7 CONTRACTOR'S OR LANDOWNER'S CERTIFICATION: This water well was (1) constructed, (2) reconstructed, or (3) plugged under my jurisdiction and was completed on (mo/day/year) 9-24-96 and this record is true to the best of my knowledge and belief. Kansas Water Well Contractor's License No. 575 This Water Well Record was completed on (mo/day/yr) 9-30-96 under the business name of AEC by (signature) [Signature]