


MW-19

1 LOCATION OF WATER WELL: County: Phillips Fraction: NW 1/4 NE 1/4 NW 1/4 Section Number: 15 Township Number: T 3 S R 19 EW

Distance and direction from nearest town or city street address of well if located within city? Approx. 300ft south of Main St. along east side of school property.

2 WATER WELL OWNER: City of Stuttgart RR#, St. Address, Box #: Stuttgart, KS Board of Agriculture, Division of Water Resources Application Number:

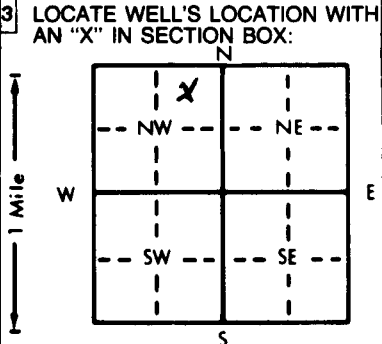

3 LOCATE WELL'S LOCATION WITH AN 'X' IN SECTION BOX: 4 DEPTH OF COMPLETED WELL: 30 ft. ELEVATION: 1993.76 FT  
Depth(s) Groundwater Encountered 1. 25.84 ft. 2. .... ft. 3. .... ft.  
WELL'S STATIC WATER LEVEL 25.84 ft. below land surface measured on mo/day/yr 11-20-96  
Pump test data: Well water was .... ft. after .... hours pumping .... gpm  
Est. Yield .... gpm: Well water was .... ft. after .... hours pumping .... gpm  
Bore Hole Diameter 7.25 in. to .... ft., and .... in. to .... ft.  
WELL WATER TO BE USED AS: 5 Public water supply 8 Air conditioning 11 Injection well  
1 Domestic 3 Feedlot 6 Oil field water supply 9 Dewatering 12 Other (Specify below)  
2 Irrigation 4 Industrial 7 Lawn and garden only 10 Monitoring well  
Was a chemical/bacteriological sample submitted to Department? Yes No; If yes, mo/day/yr sample was submitted  
Water Well Disinfected? Yes No

5 TYPE OF BLANK CASING USED: 1 Steel 3 RMP (SR) 5 Wrought iron 8 Concrete tile CASING JOINTS: Glued .... Clamped ....  
2 PVC 4 ABS 6 Asbestos-Cement 9 Other (specify below) Welded ....  
Blank casing diameter 2 IN in. to 20 ft., Dia. .... in. to .... ft., Dia. .... in. to .... ft.  
Casing height above land surface 0 in., weight .... lbs./ft. Wall thickness or gauge No. 40  
TYPE OF SCREEN OR PERFORATION MATERIAL: 7 PVC 10 Asbestos-cement  
1 Steel 3 Stainless steel 5 Fiberglass 8 RMP (SR) 11 Other (specify) ....  
2 Brass 4 Galvanized steel 6 Concrete tile 9 ABS 12 None used (open hole)  
SCREEN OR PERFORATION OPENINGS ARE: 5 Gauzed wrapped 8 Saw cut 11 None (open hole)  
1 Continuous slot 3 Mill slot 6 Wire wrapped 9 Drilled holes  
2 Louvered shutter 4 Key punched 7 Torch cut 10 Other (specify) ....  
SCREEN-PERFORATED INTERVALS: From 20 ft. to 30 ft., From .... ft. to .... ft.  
From .... ft. to .... ft., From .... ft. to .... ft.  
GRAVEL PACK INTERVALS: From 18 ft. to 30 ft., From .... ft. to .... ft.  
From .... ft. to .... ft., From .... ft. to .... ft.

6 GROUT MATERIAL: 1 Neat cement 2 Cement grout 3 Bentonite 4 Other Bentonite Seal 16-18 Ft.  
Grout Intervals: From 1 ft. to 16 ft., From .... ft. to .... ft., From .... ft. to .... ft.  
What is the nearest source of possible contamination:  
1 Septic tank 4 Lateral lines 7 Pit privy 11 Fuel storage 14 Abandoned water well  
2 Sewer lines 5 Cess pool 8 Sewage lagoon 12 Fertilizer storage 15 Oil well/Gas well  
3 Watertight sewer lines 6 Seepage pit 9 Feedyard 13 Insecticide storage 16 Other (specify below)

Direction from well? How many feet?

FROM	TO	LITHOLOGIC LOG	FROM	TO	PLUGGING INTERVALS
0	5	Bnn. firm dry clay s.l.t			
5	10	Same			
10	15	Same			
15	20	Bnn. firm dry sandy clay s.l.t			
20	30	Bnn, dry to moist, firm sandy clay s.l.t			

7 CONTRACTOR'S OR LANDOWNER'S CERTIFICATION: This water well was 1 constructed, (2) reconstructed, or (3) plugged under my jurisdiction and was completed on (mo/day/year) 11-19-96 and this record is true to the best of my knowledge and belief. Kansas Water Well Contractor's License No. 575 This Water Well Record was completed on (mo/day/yr) 11-27-96 under the business name of AEC by (signature) [Signature]