


1 LOCATION OF WATER WELL: County: **PHILLIPS** Fraction: **NE 1/4 NE 1/4 SW 1/4** Section Number: **3** Township Number: **T 3 S** Range Number: **R 19 E/W**

Distance and direction from nearest town or city street address of well if located within city?
1 1/2 Miles North of Stuttgart KS

2 WATER WELL OWNER: **SCOTT WELLS**
 RR#, St. Address, Box #: **RR1 BOX 22** Board of Agriculture, Division of Water Resources
 City, State, ZIP Code: **PRAIRIE VIEW KS 67664** Application Number:

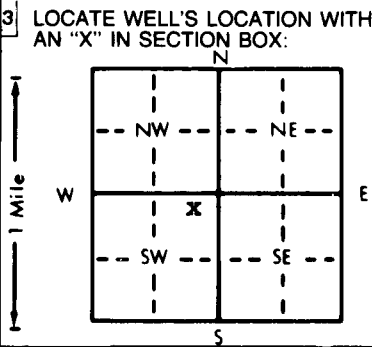

4 DEPTH OF COMPLETED WELL: **40** ft. ELEVATION:
 Depth(s) Groundwater Encountered 1. **26** ft. 2. ft. 3. ft.
 WELL'S STATIC WATER LEVEL: **22** ft. below land surface measured on **mo/day/yr 4-10-98**
 Pump test data: Well water was ft. after hours pumping gpm
 Est. Yield: **40** gpm; Well water was ft. after hours pumping gpm
 Bore Hole Diameter: **10** in. to **40** ft., and in. to ft.
 WELL WATER TO BE USED AS:
 Domestic 3 Feedlot 6 Oil field water supply 9 Dewatering 12 Other (Specify below)
 Irrigation 4 Industrial 7 Lawn and garden only 10 Monitoring well
 Was a chemical/bacteriological sample submitted to Department? Yes No ; If yes, mo/day/yr sample was submitted
 Water Well Disinfected? Yes No

5 TYPE OF BLANK CASING USED:
 1 Steel 3 RMP (SR) 5 Wrought iron 8 Concrete tile CASING JOINTS: Glued Clamped
 PVC 4 ABS 6 Asbestos-Cement 9 Other (specify below) Welded
 7 Fiberglass Threaded
 Blank casing diameter: **5** in. to **20** ft., Dia. in. to ft., Dia. in. to ft.
 Casing height above land surface: **18** in., weight **160** lbs./ft. Wall thickness or gauge No.
 TYPE OF SCREEN OR PERFORATION MATERIAL:
 Steel 3 Stainless steel 5 Fiberglass 8 RMP (SR) 10 Asbestos-cement
 2 Brass 4 Galvanized steel 6 Concrete tile 9 ABS 11 Other (specify)
 12 None used (open hole)
 SCREEN OR PERFORATION OPENINGS ARE:
 1 Continuous slot Mill slot 5 Gauzed wrapped 8 Saw cut 11 None (open hole)
 2 Louvered shutter 4 Key punched 6 Wire wrapped 9 Drilled holes
 7 Torch cut 10 Other (specify)
 SCREEN-PERFORATED INTERVALS: From **20** ft. to **40** ft., From ft. to ft.
 From ft. to ft., From ft. to ft.
 GRAVEL PACK INTERVALS: From **25** ft. to **40** ft., From ft. to ft.
 From ft. to ft., From ft. to ft.

6 GROUT MATERIAL: 1 Neat cement 2 Cement grout Bentonite 4 Other
 Grout Intervals: From **0** ft. to **25** ft., From ft. to ft., From ft. to ft.
 What is the nearest source of possible contamination:
 1 Septic tank 4 Lateral lines 7 Pit privy 10 Livestock pens 14 Abandoned water well
 2 Sewer lines 5 Cess pool 8 Sewage lagoon 11 Fuel storage 15 Oil well/Gas well
 3 Watertight sewer lines 6 Seepage pit 9 Feedyard 12 Fertilizer storage 16 Other (specify below)
 13 Insecticide storage
 Direction from well? How many feet?

| FROM | TO | LITHOLOGIC LOG | FROM | TO | PLUGGING INTERVALS |
|------|----|------------------|------|----|--------------------|
| 0 | 5 | SURFACE CLAY | | | |
| 5 | 20 | HARD GRAY CLAY | | | |
| 20 | 25 | WHITE SAND CLAY | | | |
| 25 | 30 | LARGE WATER ROCK | | | |
| 30 | 35 | CLAYS & MED SAND | | | |
| 35 | 40 | SOFT BLUE SHALE | | | |
| | | | | | |
| | | | | | |
| | | | | | |
| | | | | | |
| | | | | | |

7 CONTRACTOR'S OR LANDOWNER'S CERTIFICATION: This water well was constructed, (2) reconstructed, or (3) plugged under my jurisdiction and was completed on (mo/day/year) **4-10-98** and this record is true to the best of my knowledge and belief. Kansas Water Well Contractor's License No. **444** This Water Well Record was completed on (mo/day/yr) **4-10-98** under the business name of **ANDY ANDERSON DRILLING** by (signature) *Andy Anderson*

OFFICE USE ONLY
T
R
EW
SEC
1/4
1/4
1/4