

WATER WELL PLUGGING RECORD

Form WWC-5P

KSA 82a-1212

ID No.

MW-04


*Corrected*

1 LOCATION OF WATER WELL: County: Phillips	Fraction NE 1/4 NW 1/4 NW 1/4	Section Number 15	Township Number 3S	Range Number 19W
---	----------------------------------	----------------------	-----------------------	---------------------

Distance and direction from nearest town or city street address of well if located within city?  
Main Street, Stuttgart, KS

2 WATER WELL OWNER: Stuttgart Oil Company  
RR#, St. Address, Box #  
City, State, ZIP Code : Stuttgart, KS 67670  
Board of Agriculture, Division of Water Resources  
Application Number:

3 MARK WELL'S LOCATION WITH AN "X" IN SECTION BOX:

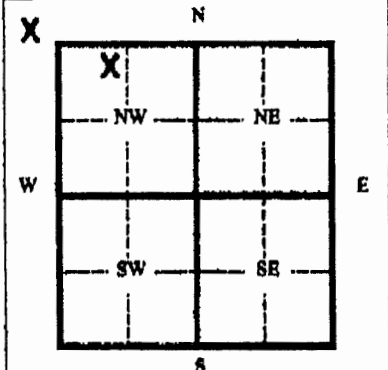

4 DEPTH OF WELL 50 ft.

WELL'S STATIC WATER LEVEL 30.5 ft.

- WELL WAS USED AS:
- |              |                              |                    |
|--------------|------------------------------|--------------------|
| 1 Domestic   | 5 Public Water Supply        | 9 Dewatering       |
| 2 Irrigation | 6 Oil Field Water Supply     | 10 Monitoring Well |
| 3 Feedlot    | 7 Lawn and Garden (domestic) | 11 Injection Well  |
| 4 Industrial | 8 Air Conditioning           | 12 Other           |

Was a chemical/bacteriological sample submitted to Department? Yes ... No ...  
If yes, mo/day/yr sample was submitted \_\_\_\_\_  
Water Well Disinfected: Yes ... No ...

5 TYPE OF BLANK CASING USED:

1 Steel	3 RMP (SR)	5 Wrought	7 Fiberglass	9 Other (specify below)
2 PVC	4 ABC	6 Asbestos-Cement	8 Concrete Tile	

Blank casing diameter 2 in. Was casing pulled? Yes  No \_\_\_\_\_ If yes, how much removed 3 ft.  
Casing height above or below land surface -36 in.

6 GROUT PLUG MATERIAL: 1 Neat cement 2 Cement grout 3 Bentonite 4 Other \_\_\_\_\_  
Grout Plug Intervals From 0 ft. to 50 ft. From \_\_\_\_\_ ft. to \_\_\_\_\_ ft. From \_\_\_\_\_ ft. to \_\_\_\_\_ ft.

- What is the nearest source of possible contamination:
- |                          |                   |                         |                          |
|--------------------------|-------------------|-------------------------|--------------------------|
| 1 Septic tank            | 6 Seepage pit     | 11 Fuel storage         | 16 Other (specify below) |
| 2 Sewer lines            | 7 Pit privy       | 12 Fertilizer storage   |                          |
| 3 Watertight sewer lines | 8 Sewage lagoon   | 13 Insecticide storage  |                          |
| 4 Lateral lines          | 9 Feedyard        | 14 Abandoned water well |                          |
| 5 Cess Pool              | 10 Livestock pens | 15 Oil well/ Gas well   |                          |

Direction from well? \_\_\_\_\_ How many feet? \_\_\_\_\_

FROM	TO	CODE	PLUGGING MATERIALS
0	50		Bentonite grout

**RECEIVED**  
JAN 08 2009  
**BUREAU OF WATER**

7 CONTRACTOR'S OR LANDOWNER'S CERTIFICATION: This water well was plugged under my jurisdiction and was completed on (mo/day/yr) 10/9/08 and this record is true to the best of my knowledge and belief. Kansas Water Well Contractor's License No. 554 This Water Well Record was completed on (mo/day/yr) 10/22/08 under the business name of Nilchit Bluestem Environmental Engineering, Inc. by (signature) *Nilchit*

INSTRUCTIONS: Please fill in blanks and circle the correct answers. Send three copies to Kansas Department of Health and Environment, Bureau of Water, 1000 S W Jackson St., Ste. 420, Topeka, Kansas 66620-0001. Telephone: 785-298-3565. Send one to Water Well Owner and retain one for your records.