

WATER WELL PLUGGING RECORD

Form WWC-5P

KSA 82a-1212

ID No.


MW-14R

1 LOCATION OF WATER WELL: County: Phillips	Fraction NE 1/4 NW 1/4 NW 1/4	Section Number 15	Township Number 3S	Range Number 19W
---	----------------------------------	----------------------	-----------------------	---------------------

Distance and direction from nearest town or city street address of well if located within city?  
Main Street, Stuttgart, KS

2 WATER WELL OWNER: Stuttgart Oil Company  
RR#, St. Address, Box #  
City, State, ZIP Code : Stuttgart, KS 67670

Board of Agriculture, Division of Water Resources  
Application Number:

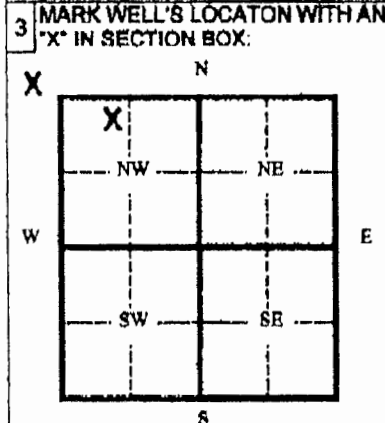

4 DEPTH OF WELL 35 ft.

WELL'S STATIC WATER LEVEL 30 ft.

WELL WAS USED AS:

1 Domestic	5 Public Water Supply	9 Dewatering
2 Irrigation	6 Oil Field Water Supply	10 Monitoring Well
3 Feedlot	7 Lawn and Garden (domestic)	11 Injection Well
4 Industrial	8 Air Conditioning	12 Other

Was a chemical/bacteriological sample submitted to Department? Yes \_\_\_ No \_\_\_  
If yes, mo/day/yr sample was submitted \_\_\_\_\_  
Water Well Disinfected: Yes \_\_\_ No \_\_\_

5 TYPE OF BLANK CASING USED:

1 Steel	3 RMP (SR)	5 Wrought	7 Fiberglass	9 Other (specify below)
2 PVC	4 ABC	6 Asbestos-Cement	8 Concrete Tile	

Blank casing diameter 2 in. Was casing pulled? Yes  No \_\_\_ If yes, how much removed 3 ft.  
Casing height above or below land surface -36 in.

6 GROUT PLUG MATERIAL: 1 Neat cement 2 Cement grout 3 Bentonite 4 Other

Grout Plug Intervals From 0 ft. to 35 ft. From \_\_\_ ft. to \_\_\_ ft. From \_\_\_ ft. to \_\_\_ ft.

What is the nearest source of possible contamination:

1 Septic tank	6 Seepage pit	11 Fuel storage	16 Other (specify below)
2 Sewer lines	7 Pit privy	12 Fertilizer storage	
3 Watertight sewer lines	8 Sewage lagoon	13 Insecticide storage	
4 Lateral lines	9 Feedyard	14 Abandoned water well	
5 Cess Pool	10 Livestock pans	15 Oil well/ Gas well	

Direction from well? \_\_\_\_\_ How many feet? \_\_\_\_\_

FROM	TO	CODE	PLUGGING MATERIALS
0	35		Bentonite grout

RECEIVED  
JAN 08 2009  
BUREAU OF WATER

7 CONTRACTOR'S OR LANDOWNER'S CERTIFICATION: This water well was plugged under my jurisdiction and was completed on (mo/day/yr) 10/9/08 and this record is true to the best of my knowledge and belief. Kansas Water Well Contractor's License No. 554 This Water Well Record was completed on (mo/day/yr) 10/22/08 under the business name of \_\_\_\_\_ Bluestem Environmental Engineering, Inc.  
by (signature) *Nick Holt* *Jay C. Webster*

INSTRUCTIONS: Please fill in blanks and circle the correct answers. Send three copies to Kansas Department of Health and Environment, Bureau of Water, 1000 S W Jackson St., Ste. 420, Topeka, Kansas 66620-0001. Telephone: 785-298-3565. Send one to Water Well Owner and retain one for your records.